


Site Code: <b>MNO12</b>	Location: <b>C</b>	Grid Sq: <b>15/210</b>	Context Type: <b>MASONRY</b>	Context Number: <b>34<del>2</del> 12</b>
1. Materials	1. <sup>peg</sup> TILE, BRICK, MORTAR			
2. Size of materials (brick: BTL in mm)	2. BRICK - 230mm x 100mm, TILE 290mm x 170mm (MAX) x60mm x50mm			
3. Finish of stones	3. /			
4. Coursing / bond	4. <del>SANDY</del> YELLOW/GREY MORTAR, DOUBLE COURSE OF TILE. MORTAR			
5. Form	5. BRICKS DRAIN COVER SANDY MORTAR WITH FLECKS OF WHITES			
6. Direction of face(s)	6. (LIME?) AND GRAVEL (1-2mm)			
7. Surface treatment	7. 5. DRAIN COVER			
8. Bonding material (if brick: record height of 4 courses & 4 bed joints in m)	8. 6. -			
9. Dimensions of masonry as found	9. 7. -			
10. Other comments	9. 8. APPROX. 50mm - 60mm THICK			
				Max Level: 11.72 m OD
				Min Level: 11.62 m OD

Stratigraphic Relationships:

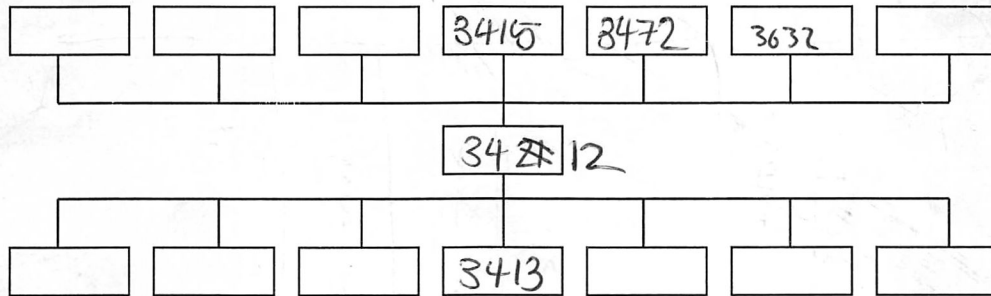

Physical Relationships:

Abuts:	Abutted by:
Cut by:	

Interpretation:	internal	external	peg
BRICK + TILE COVER OF A BRICK DRAIN. <del>DOWN</del> TWO LAYERS OF TILE MORTARED TOGETHER WITH A YELLOW SANDY MORTAR WITH ANOTHER LAYER OF <del>PORE</del> MORTAR BELOW TO FIX IT TO THE DRAIN. WHERE THE <del>DRAIN</del> IS TUNNELLED UNDER WALL [3 <del>47</del> 1] STONE SLABS ARE USED FOR THE DRAIN COVER BELOW THE B WALL REPAIR. WHERE THE <del>DRAIN</del> WAS TUNNELLED WITHOUT THE NEED FOR REPAIR TO THE WALL PEG TILE WAS USED. <del>AS</del> <del>SE</del> THREE LAYER OF TILE APPEAR TO HAVE BEEN PUSHED UNDER THE WALL TO CREATE A COVER AND FILL THE GAP. A WHITISH MORTAR WITH FEW CHARCOAL FLECKS WAS USE FOR THE STONE COVER.			
Context same as:			

Sample No(s):	Drawing No(s): 3421 (x4)
Photo No(s): 6327-6338-6345 6304-6324-6359-6362	Sketch/levels overleaf <input checked="" type="checkbox"/> Transferred to plan <input checked="" type="checkbox"/>

Compiled by: ABJ	Date: 22/5/15	Checked by: en 21/01/5	Tick when entered in database: <input type="checkbox"/>
---------------------	------------------	---------------------------	---

Context Number:

3421

Level No.s 1-6  
 TBM 12.46 11.40  
 B/S 1.06  
 IH 13.52 12.46

Level No.s 7  
 TBM 11.40  
 B/S 1.12  
 IH 12.52

Level No.s 8-9  
 TBM 11.40  
 B/S 1.17  
 IH 12.57

Level No.s  
 TBM  
 B/S  
 IH

No.	F/S	R/L (m OD)	No.	F/S	R/L (m OD)	No.	F/S	R/L (m OD)	No.	F/S	R/L (m OD)
1	1.90	10.52	6	1.94	10.52						
2	1.82	10.504	7	1.94	10.58						
3	1.80	10.526	8	2.01	10.56						
4	1.80	10.526	9	2.03	10.54						
5	1.81	10.565	10	2.04	10.53						

