


Site Code: <b>MNO12</b>	Location: <b>C</b>	Grid Sq: <b>155/210</b> <b>155/05</b>	Context Type: <b>MASONRY</b>	Context Number: <b>3414</b>
1. Materials	① <b>BRICK + MORTAR</b>			
2. Size of materials (brick: BTL in mm)	② <del>225</del> <b>0.225 x 0.105 m (max), 0.11m x 0.105m, 0.9 m x 0.105m</b>			
3. Finish of stones	③ <b>-</b>			
4. Coursing / bond	④ <b>ROWS OF HEADERS ON BED</b> <del>WITH</del>			
5. Form	⑤ <b>WALL</b>			
6. Direction of face(s)	⑥ <b>-</b>			
7. Surface treatment	⑦ <b>-</b>			
8. Bonding material (if brick: record height of 4 courses & 4 bed joints in m)	⑧ <b>4 COURSES : 0.30m HIGH. MORTAR - LIGHT GREY</b>			
9. Dimensions of masonry as found	⑨ <b>4.80m (N-S), <del>0.33m</del> 0.33m - 0.36m (E-W)</b>			
10. Other comments	<b>0.30m HEIGHT (MAX).</b>			Max Level: <b>10.76 m OD</b>
10. TRUNCATED/TUNNELLED BY BRICK DRAIN [3413]				Min Level: <b>10.42 m OD</b>

Stratigraphic Relationships:

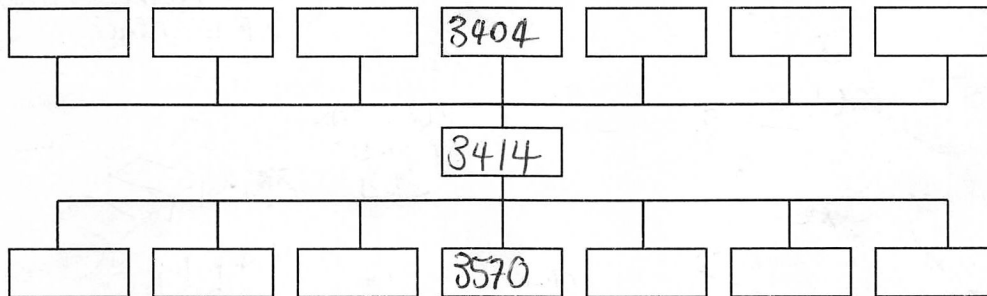

Physical Relationships:

Abuts:	Abutted by:
Cut by: <b>[3473]</b>	

Interpretation:	internal	external
<b>BRICK WALL ORIGINATED N-S. PARTY WALL. MAXIMUM 4 COURSES SURVIVING. TOP COURSE IS A ROW OF HEADERS ON BED, CENTRALLY LOCATED. SECOND COURSE IS A ROW OF HEADERS ON BED AND HALF BRICKS, CREATING AN <del>TRUNCATED</del> OF SET THE WALL <del>WAS</del> <sup>PARTIALLY</sup> TRUNCATED BY A BRICK DRAIN [3413] AND REBUILT [3415].</b>		
Context same as:		

Sample No(s):	Drawing No(s): <b>3414 (x2)</b>
Photo No(s):	Sketch/levels overleaf: <input checked="" type="checkbox"/> Transferred to plan: <input type="checkbox"/>

Compiled by: <b>AB</b>	Date: <b>22/5/15</b>	Checked by: <b>ca/10/15</b>	Tick when entered in database: <input type="checkbox"/>
---------------------------	-------------------------	--------------------------------	---

Context Number:  
3414

Level No.s 1-19  
TBM 11.40  
B/S 0.56  
IH ~~11.96~~

Level No.s 20-23  
TBM 11.40  
B/S 0.85  
IH 12.25

Level No.s  
TBM  
B/S  
IH

Level No.s  
TBM  
B/S  
IH

No.	F/S	R/L (m OD)	No.	F/S	R/L (m OD)	No.	F/S	R/L (m OD)	No.	F/S	R/L (m OD)
1	1.20	10.76	6	1.80	10.74	11	1.31	10.65	16	1.30	10.66
2	1.22	10.74	7	1.21	10.75	12	1.24	10.72	17	1.30	10.66
3	1.26	10.70	8	1.22	10.74	13	1.31	10.65	18	1.29	10.67
4	1.28	10.68	9	1.15	10.81	14	1.22	10.74	19	1.29	10.67
5	1.25	10.71	10	1.23	10.73	15	1.20	10.76	20	1.71	10.54

21 1.70 10.55  
22 1.74 10.51  
23 1.82 10.42

BASE OF WALL

N  
NTS

WALL [3465]

ACUTE ANGLE SECTION OF EAST FACE

TRUNCATION BY DRAIN [3413]

BASE OF WALL

MORTAR

[3414]

BRICK DRAIN [3413] TUNNELLED WITH A REBUILD [3415]

WALL [3142]