


Site Code: <b>MNO12</b>	Location: <b>C</b>	Grid Sq: <b>145-150/210</b>	Context Type: <b>MASONRY</b>	Context Number: <b>3581 1/2</b>
1. Materials	1. <del>RED</del> SLIGHTLY FROCKED BRICKS, PURPLE RED SLIGHTLY FROCKED BRICKS			
2. Size of materials (brick: BTL in mm)	1. <del>110</del> 110 x 70 x 220			
3. Finish of stones	3. -			
4. Coursing / bond	4. ROUGHLY ENGLISH			
5. Form	5. BRICK-LINED SILT TRAP - SOME RE-USED BRICKS?			
6. Direction of face(s)	6. -			
7. Surface treatment	7. SOME LIMESCALE DAMAGE SEEN ON WEST AND NORTH WALLS [3443] INDICATING USE OF OLDER WALLS AS CESS. WALLS OF [3581] BUILD-UP SHOW NO SUCH DAMAGE? OR LIMESCALE ABOVE NORMAL WATER LEVEL OF SILT TRAP - L.			
8. Bonding material (if brick: record height of 4 courses & 4 bed joints in m)	AND LIMESCALE CAUSED BY RISE, FALL AND FREQ DRYING OUT OF WATER ON WALLS ABOVE DRAIN BASE LEVEL.			
9. Dimensions of masonry as found				Max Level: 10.47m OD
10. Other comments				Min Level: 9.41 m OD

Stratigraphic Relationships:

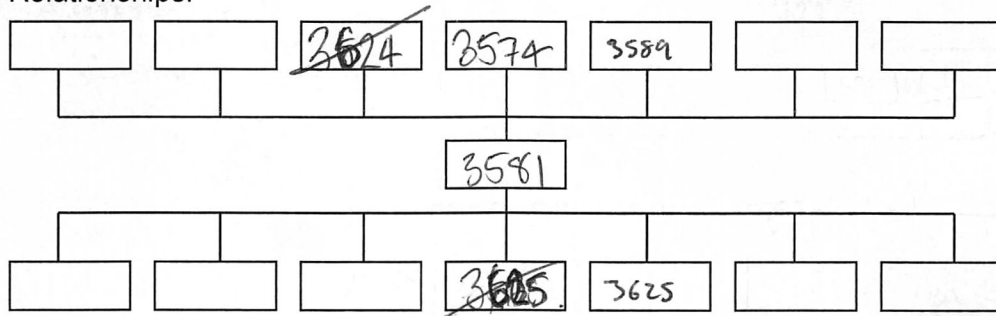

Physical Relationships:

Abuts: [3443] AND [3455]	Abutted by:
Cut by:	

Interpretation:	internal	external
SILT TRAP WALL		
WALL HAS BEEN INSERTED BETWEEN STRUCTURAL WALLS [3443] AND [3455], AND BUILT WITH DRAIN OPENING IN SOUTHERN ELEVATION TO CONNECT WITH BRICK LINED DRAIN [3589] WITH WHICH [3581] SHARES A CONSTRUCTION CUT [3605] [3625]. THERE IS ALSO ANOTHER INBUILT NARROW OPENING IN SOUTHERN END OF EASTERN ELEVATION, PERHAPS FOR OTHER DRAINAGE IN OR OUT OF SILT TRAP.		
Context same as:		


Sample No(s):	2 BRICKS	Drawing No(s):	3581 (x 2)
Photo No(s):		Sketch/levels overleaf:	<input type="checkbox"/>
		Transferred to plan:	<input type="checkbox"/>

Compiled by:	Date:	Checked by:	Tick when entered in database:
<i>NJ</i>	3/5/15	<i>aslo/s</i>	<input type="checkbox"/>

Context Number:  
3581.

Level No.s	Level No.s	Level No.s	Level No.s
TBM	TBM 11.40	TBM	TBM
B/S	B/S 1.00	B/S	B/S
IH	IH 12.40	IH	IH

No.	F/S	R/L (m OD)	No.	F/S	R/L (m OD)	No.	F/S	R/L (m OD)	No.	F/S	R/L (m OD)
1		10.82	6		9.43	11	10.78	10.78			
2		10.82	7		10.81	12		9.53			
3		9.41	8		10.81	13		9.44			
4		9.45	9		10.24	14	2.10	10.30			
5		9.44	10		10.30						

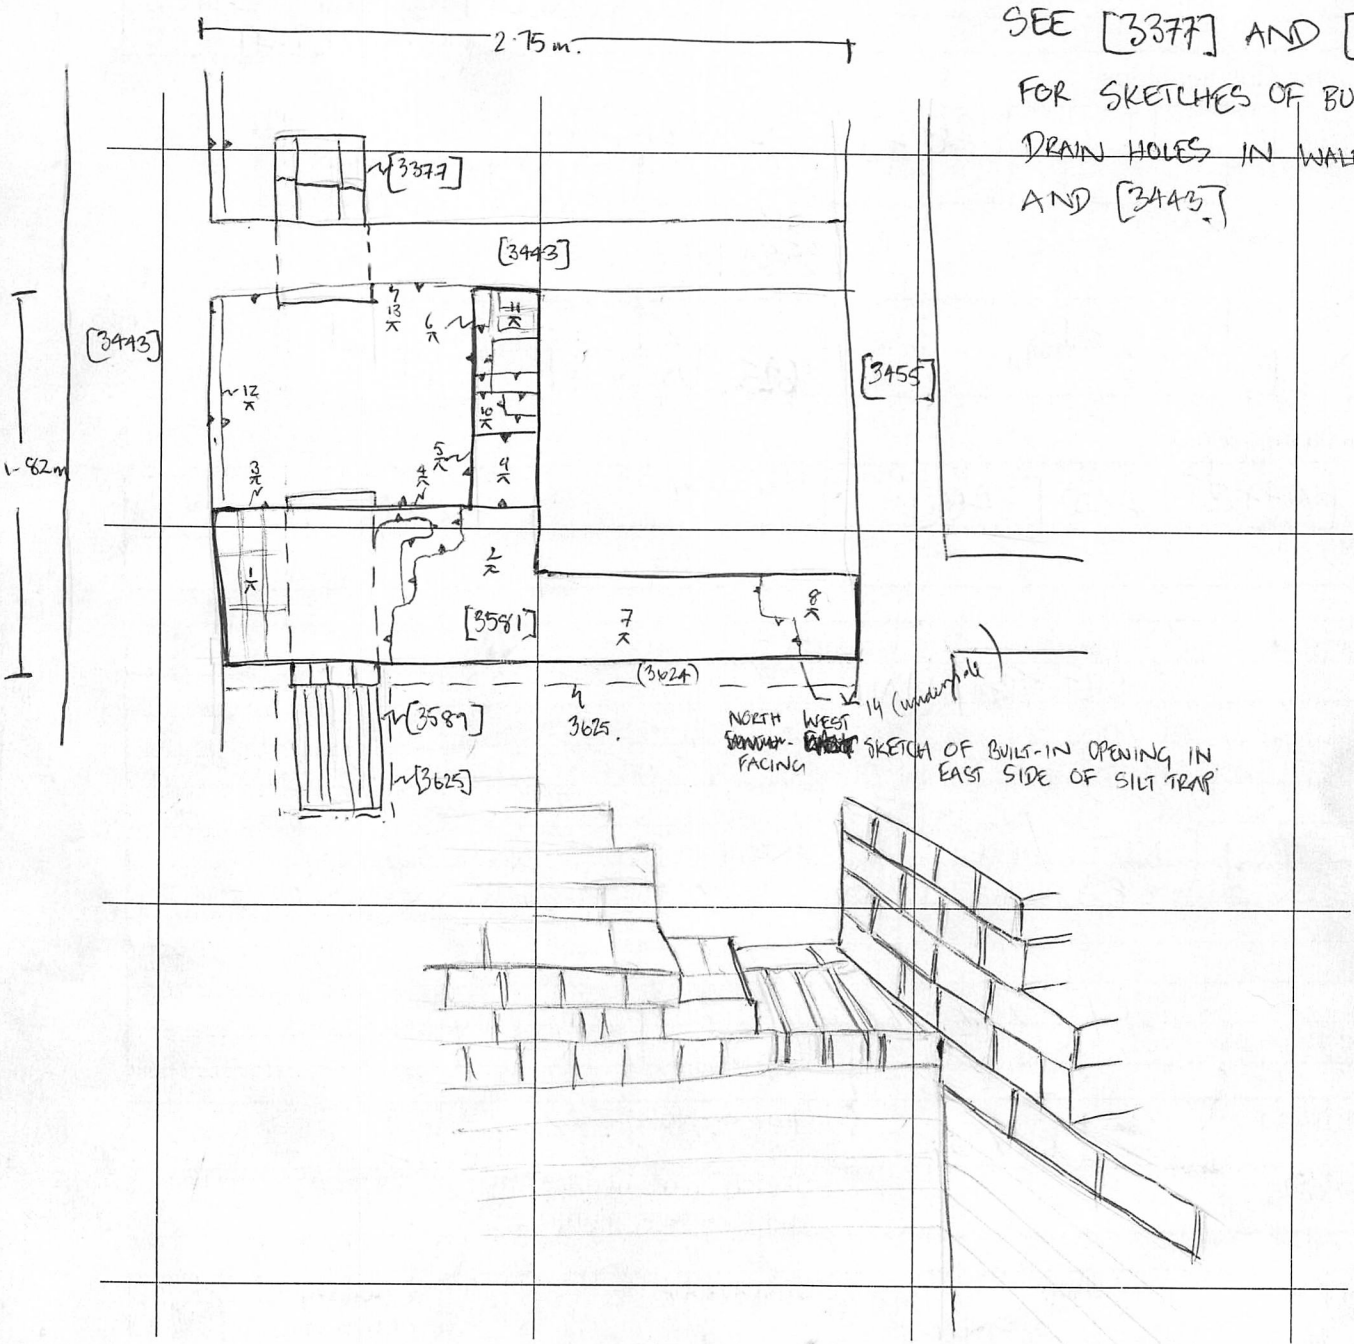

SEE [3377] AND [3589]  
FOR SKETCHES OF BUILT IN  
DRAIN HOLES IN WALLS [3581]  
AND [3443]

14 (underplate)  
NORTH WEST  
SKETCH OF BUILT-IN OPENING IN  
EAST SIDE OF SILT TRAP



Context Number:  
3581

Level No.s  
TBM 11.40  
B/S 0.45  
IH 12.25

Level No.s 31  
TBM 11.40  
B/S 0.75  
IH 12.15


Level No.s  
TBM  
B/S  
IH

Level No.s  
TBM  
B/S  
IH

No.	F/S	R/L (m OD)	No.	F/S	R/L (m OD)	No.	F/S	R/L (m OD)	No.	F/S	R/L (m OD)
1	1.38	10.87	6	1.43	10.82	11	2.82	9.43	16	1.38	10.87
2	2.12	10.13	7	2.80	9.45	12	2.81	9.44	17	1.58	10.67
3	2.72	9.53	8	2.01	10.24	13	2.77	9.46	18	1.98	10.27
4	1.43	10.82	9	2.81	9.44	14	1.95	10.30	19	2.01	10.04
5	2.84	9.41	10	1.47	10.78	15	1.44	10.81	20	1.53	10.72

BASE OF WALL  
31 2.72 9.43

21 1.45 10.80  
22 1.59 10.66  
23 1.99 10.26  
24 2.06 10.19  
25 1.47 10.78  
26 1.54 10.71  
27 2.02 10.16  
28 2.16 10.09  
29 1.32  
30 1.26  
10.93  
10.99

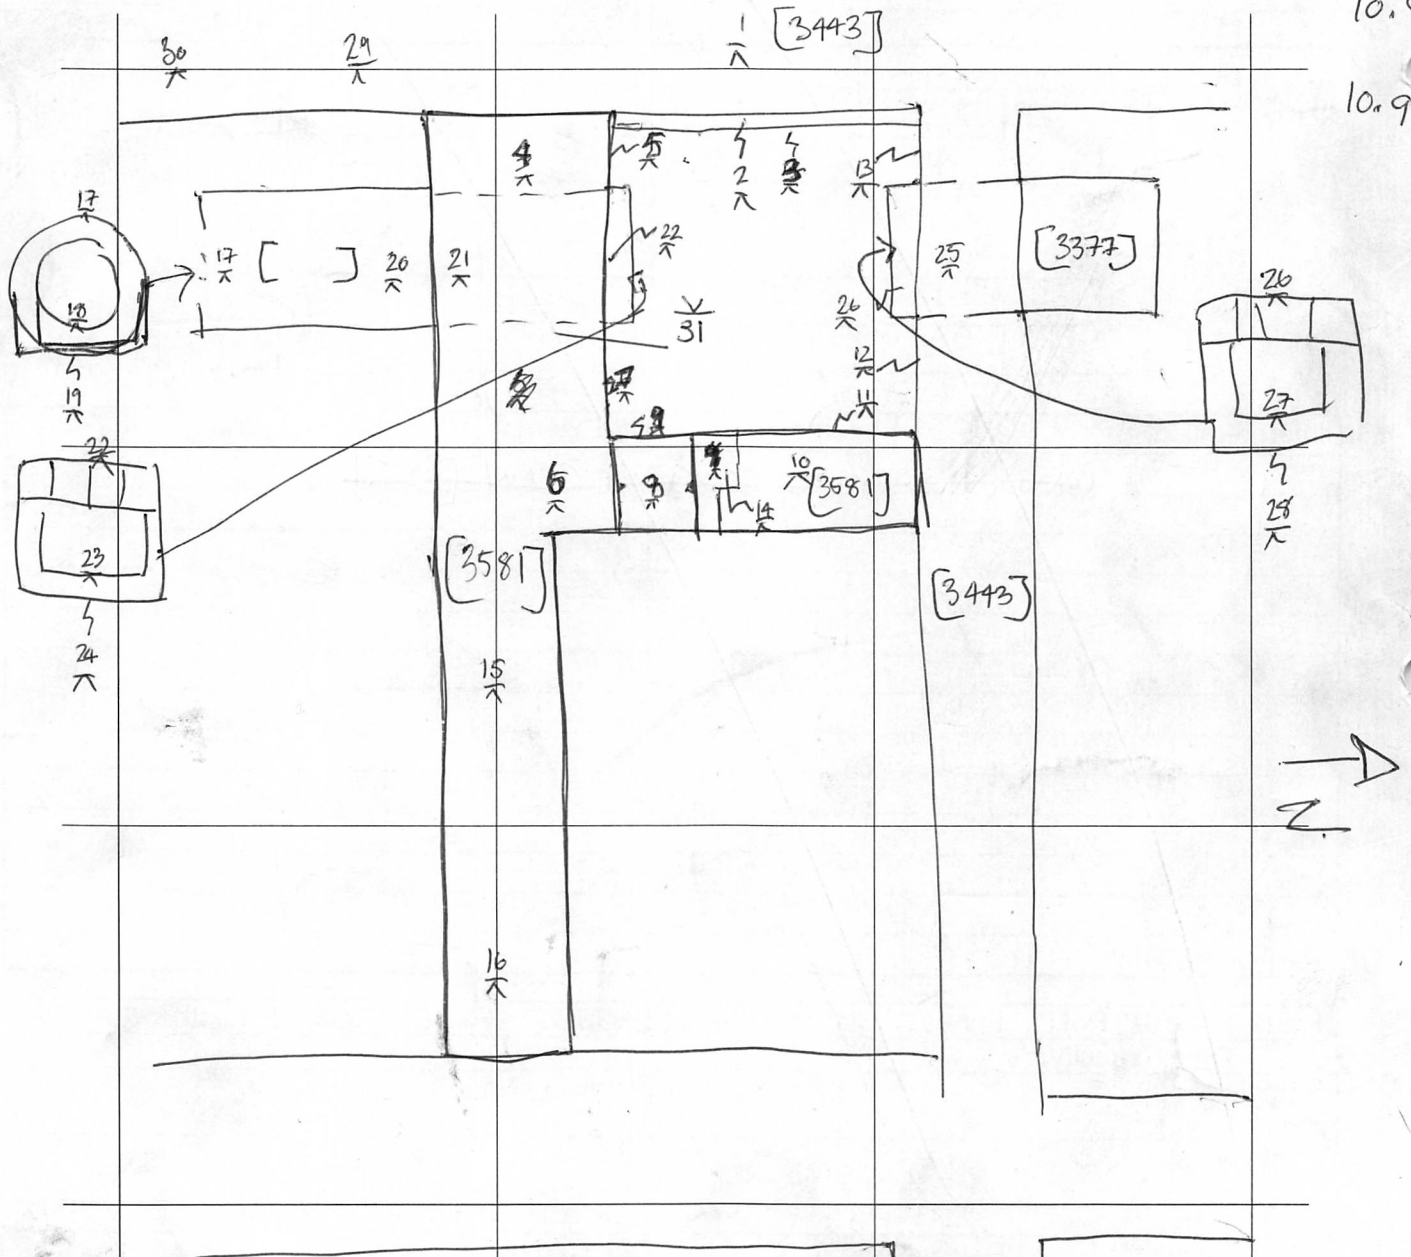

Sketch Plan & Notes