


Site Code: MNO12	Location: D	Grid Sq: 155/220	Context Type: MASONRY	Context Number: 3909
1. Materials	1. RED BRICKS			
2. Size of materials (brick: BTL in mm)	2. 55 to 100 x 60 x 220 to 230 mm			
3. Finish of stones	3. MOULDED			
4. Coursing / bond	4. MADE OF SOME STRETCHERS ON BED WITH SOME WHOLE BRICKS AND HALF BRICKS			
5. Form	5. LINEAR RUNNING E-W. CONSERVED ON 5 COURSES			
6. Direction of face(s)	6. SOUTH, NORTH, UP			
7. Surface treatment	7. NONE HARD			
8. Bonding material (if brick: record height of 4 courses & 4 bed joints in m)	8. WHITE CEMENT/MORTAR. WITH OCC. CBP FLECKS AND CHARCOAL FLECKS AND FREQ. LIME FLECKS AND small gravel (2-5mm)			
9. Dimensions of masonry as found	9. 2.10m (E-W) x 0.16 (N-S) x 0.34m.			
10. Other comments	10. last COURSE PRESERVED IS OFFSET FROM		Max Level: 10.57 m OD	
THE rest (toward the SOUTH). FIRST 2 COURSES MAINLY BUILT WITH			Min Level: 10.29 m OD	

Stratigraphic Relationships: **half-bond.**

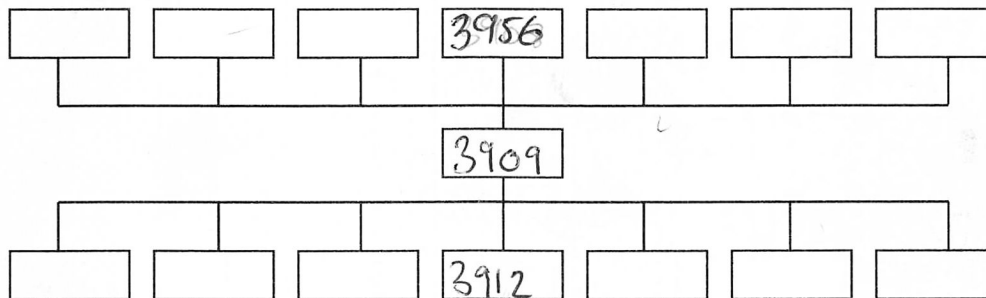

Physical Relationships:

Abuts:	Abutted by:
Cut by: CONCRETE DRAIN [+]	

Interpretation:	internal	external
BRICK BUILT DRAIN WITH PROBABLY A SQUARE SHAPED SECTION, located East of drain [3910]. It was probably a RESULT of [3910], possibly linked with curvy drain [3941].		
Context same as:		

Sample No(s):	—	Drawing No(s):	3909 (x 1)
Photo No(s):	44	Sketch/levels overleaf:	<input checked="" type="checkbox"/>
		Transferred to plan:	<input type="checkbox"/>

Compiled by:	Date:	Checked by:	Tick when entered in database:
AC	18.06.2015	~2/10/15	<input type="checkbox"/>

Context Number:
3909


Level No.s
TBM 11.40
B/S 0.76
IH 12.16

Level No.s ~~9-11~~
TBM ~~11.40~~
B/S ~~0.85~~
IH ~~12.25~~

Level No.s
TBM
B/S
IH

Level No.s
TBM
B/S
IH

No.	F/S	R/L (m OD)	No.	F/S	R/L (m OD)	No.	F/S	R/L (m OD)	No.	F/S	R/L (m OD)
1	1.87	10.29	6	1.74	10.42	9	1.74	10.51	14		
2	1.79	10.37	7	1.93	10.23	10	1.78	10.47			
3	1.64	10.52	8	1.95	10.21	11	1.77	10.48			
4	1.59	10.57				12					
5	1.66	10.50				13					

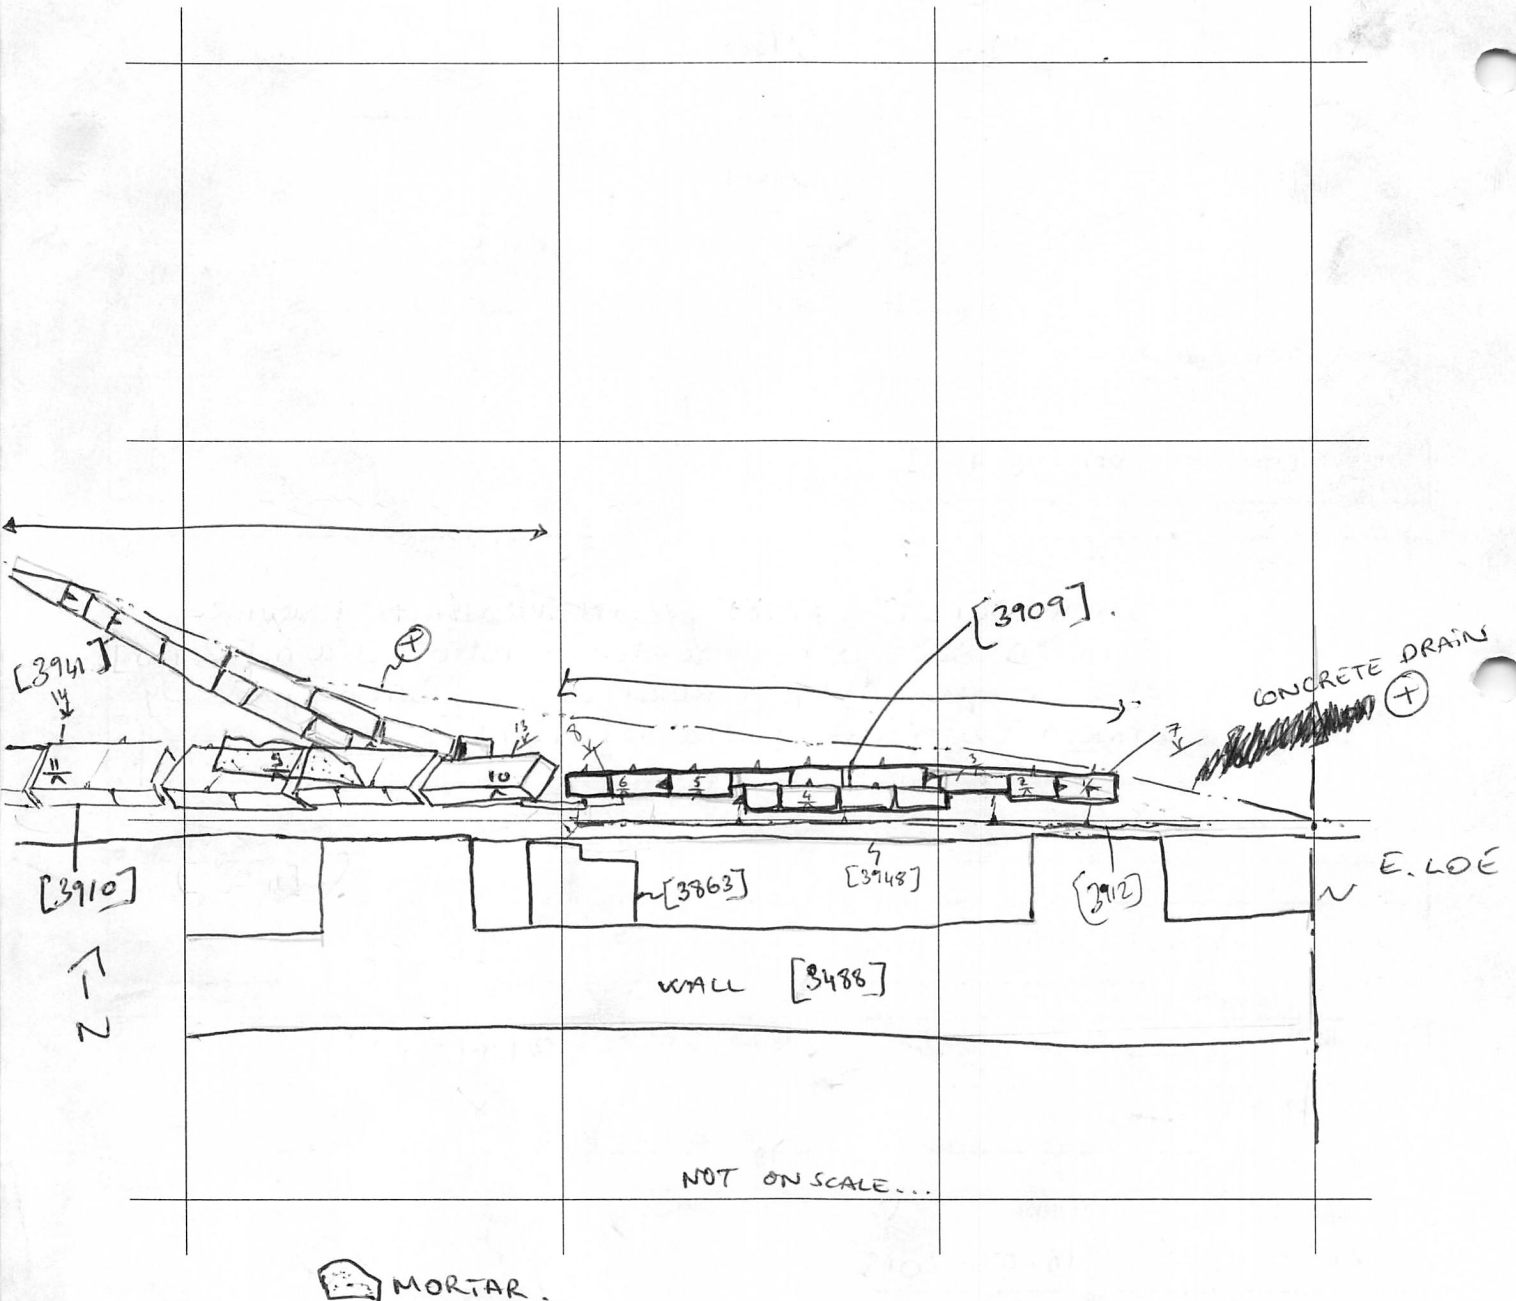

Sketch Plan & Notes