


Site Code: MNO12	Location: AREA D	Grid Sq: 155 225	Context Type: Cut	Context Number: [4037] [4038]
Deposit				Cut
1. Compaction	1. linear			1. Shape in Plan
2. Colour	2. N/A			2. Corners
3. Composition	3. 3.10m (E-W); 0.50m (N-S); 0.40m deep			3. Dimensions
4. Inclusions	4. sharp			4. Break of slope - Top
5. Interface	5. almost vertical			5. Sides
6. Dimensions	6. sharp			6. Break of slope - Base
7. Other Comments	7. flat			7. Base
8. Method/Conditions	Text 8. E-W			8. Orientation
	9. /			9. Inclination
	10. [+]			10. Truncation
	11. /			11. Other comments
				Max Level: 10.49 m OD
				Min Level: 10.10 m OD

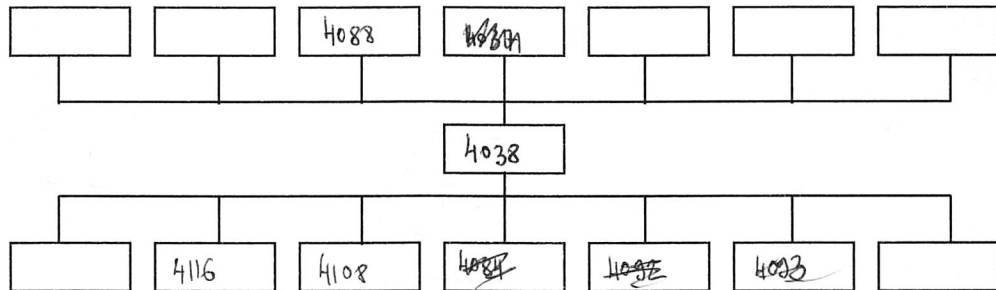

Interpretation:	Internal	External <input checked="" type="checkbox"/>	Structural
<p>Drain cut for [4037]. The cut cuts through an earlier drain backfill construction backfill and fill. It is linear, running E-W, same as [4047]. The drain cuts through an earlier internal wall in Georgian building [4085] and brick floor [4087].</p>			
Context same as: [4047]			

Finds: None <input type="checkbox"/> Pot <input type="checkbox"/> Bone <input type="checkbox"/> Glass <input type="checkbox"/> Metal <input type="checkbox"/> CBM <input type="checkbox"/> Flint <input type="checkbox"/> Wood <input type="checkbox"/> Leather <input type="checkbox"/>	
Other (specify):	
Sample No(s):	Drawing No(s): 4038 (x 1)
Photo No(s): <i>M</i>	Sketch/levels overleaf: <input checked="" type="checkbox"/> Transferred to plan: <input checked="" type="checkbox"/>

Compiled by: MK	Date: 24-06-2015	Checked by: <i>a zolis</i>	Tick when entered in database: <input type="checkbox"/>
--------------------	---------------------	-------------------------------	---

Context Number:
[4038]


Level No.s 1-~~16~~ 16
TBM 11.40
B/S ~~11.40~~ 0.66
IH ~~11.80~~ 12.06

Level No.s
TBM
B/S
IH

Level No.s
TBM
B/S
IH

Level No.s
TBM
B/S
IH

No.	F/S	R/L (m OD)	No.	F/S	R/L (m OD)	No.	F/S	R/L (m OD)	No.	F/S	R/L (m OD)
1	1.32	10.4874	6	1.69	10.4837	11	1.34	10.4672	16	1.29	10.5177
2	1.68	10.4238	7	1.64	10.4642	12	1.47	10.3859			
3	1.31	10.4875	8	1.45	10.3861	13	1.31	10.4975			
4	1.50	10.3656	9	1.70	10.4836	14	1.34	10.4672			
5	1.65	10.4841	10	1.68	10.4238	15	1.35	10.4871			

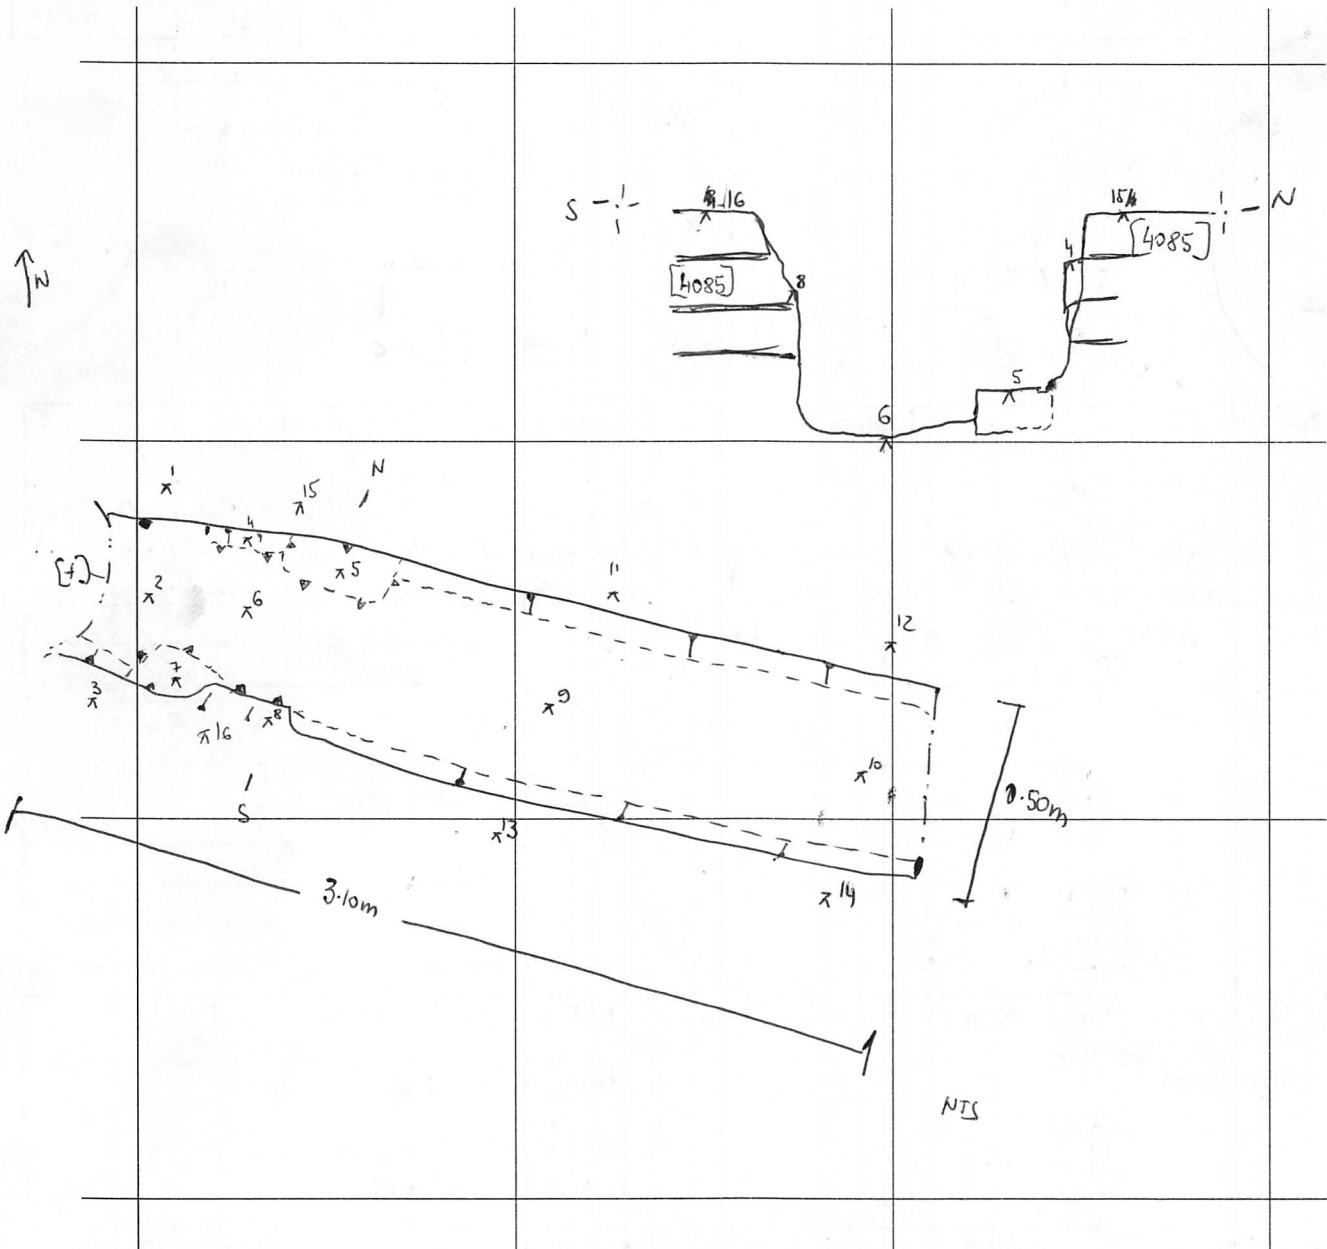

Sketch Plan & Notes