


Site Code: <b>MNO12</b>	Location: <b>D</b>	Grid Sq: <b>150/230</b>	Context Type: <b>MASONRY</b>	Context Number: <b>4090</b>
1. Materials	1. <b>RED BRICKS</b>			
2. Size of materials (brick: BTL in mm)	2. <b>100 x 60 x ? (incomplete)</b>			
3. Finish of stones	3. <b>moulded bricks</b>			
4. Coursing / bond	4. <b>Made of stretchers on bed mainly half bricks at this part of the wall</b>			
5. Form				
6. Direction of face(s)	5. <b>linear running N-S</b>			
7. Surface treatment	6. <b>VP</b>			
8. Bonding material (if brick: record height of 4 courses & 4 bed joints in m)	7. <b>none</b>			
9. Dimensions of masonry as found	8. <b>hard white mortar with lime and <del>flashes</del> charcoal flecks with occ. CBN flecks.</b>			
10. Other comments	9. <b>0.36 (N-S) x 0.23</b>			
				Max Level: <b>10.55 m OD</b>
				Min Level: <b>m OD</b>

Stratigraphic Relationships:

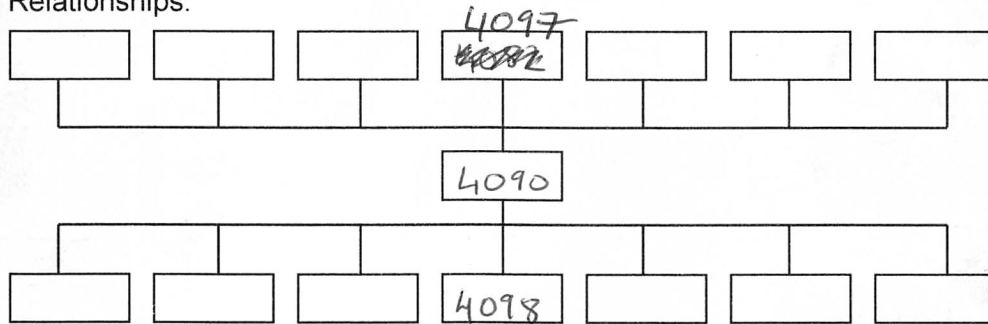

Physical Relationships:

Abuts:	Abutted by:
Cut by: <b>4082</b>	<b>SAME AS [4091]</b>

Interpretation:	internal	external
<p><b>PROBABLY BUILT DURING THE SAME TIME AS SILT TRAP AND DRAIN SYSTEM.</b></p> <p><del>(SILT TRAP AND DRAIN SYSTEM) TRUNCATED BY [4091]</del></p> <p><del>Probably built to an earlier building before (Georgean) AS SOUTHERN PART OF THE WALL WAS PART OF EASTERN WALL OF SILT TRAP AND TRUNCATED BY LATEST PHASE OF DRAIN SYSTEM.</del></p>		
Context same as: <b>[4091]</b>		

Sample No(s): <b>—</b>	Drawing No(s): <b>4090 (x1)</b>
Photo No(s): <b>—</b>	Sketch/levels overleaf: <input checked="" type="checkbox"/> Transferred to plan: <input checked="" type="checkbox"/>

Compiled by: <b>AC</b>	Date: <b>29-06-15</b>	Checked by: <b>—/10/15</b>	Tick when entered in database: <input type="checkbox"/>
---------------------------	--------------------------	-------------------------------	---

Context Number:  
4090

Level No.s  
TBM 11.40  
B/S 0.66  
IH 12.06 m od

Level No.s  
TBM 11.40  
B/S 0.49  
IH 11.80 m

Level No.s  
TBM  
B/S  
IH

Level No.s  
TBM  
B/S  
IH

No.	F/S	R/L (m OD)	No.	F/S	R/L (m OD)	No.	F/S	R/L (m OD)	No.	F/S	R/L (m OD)
1	1.25	1084									

