


Site Code: <b>MNO12</b>	Location: AREA <b>(D)</b>	Grid Sq: 145/ <del>225</del> 225	Context Type: <b>MASONRY</b>	Context Number: <b>4156</b>
1. Materials	<b>(1)</b> RED BRICK - ALSO ONE PIECE OF POSS KENTISH RED			
2. Size of materials (brick: BTL in mm)	<b>(2)</b> 140mm x 210mm x 100-110mm x 60-70mm			
3. Finish of stones	<b>(3)</b> HANDMADE, UNFROGGED			
4. Coursing / bond	<b>(4)</b> 3 COURSES UNCOVERED - TOP COURSE STRETCHER, MIDDLE COURSE HEADERS, BOTTOM COURSE SINGLE BRICK			
5. Form	<b>(5)</b> WALL			
6. Direction of face(s)	<b>(6)</b> NORTH AND SOUTH			
7. Surface treatment	<b>(7)</b> NONE OBSERVED			
8. Bonding material (if brick: record height of 4 courses & 4 bed joints in m)	<b>(8)</b> LIGHT YELLOWISH GREY SANDY MORTAR <del>20mm THICK</del> BED JOINTS COURSE, <del>20mm THICK</del> COURSES			
9. Dimensions of masonry as found	<b>(9)</b> NS = 220mm EW = 400mm HEIGHT = 200mm			
10. Other comments				Max Level: 10.56 m OD Min Level: 10.36 m OD

Stratigraphic Relationships:

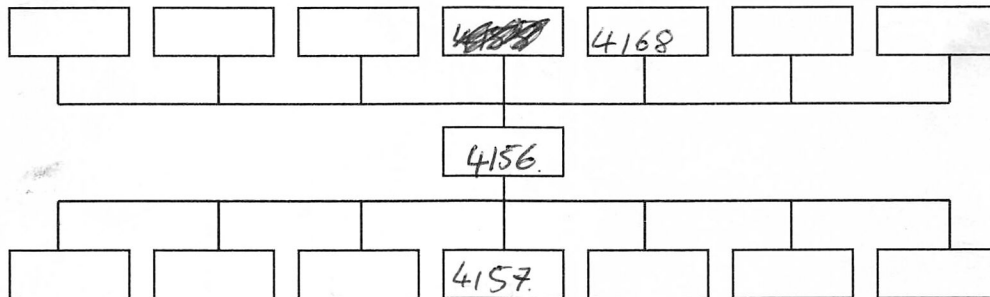

Physical Relationships:

Abuts: <b>4158</b>	Abutted by: <b>4154</b>
Cut by:	

Interpretation:	internal	<u>external</u>
<b>POSSIBLE BOUNDARY WALL FOR PRE GEORGIAN PLOT.</b>		
Context same as:		

Sample No(s):	Drawing No(s): <b>4156 (x 1)</b>
Photo No(s):	Sketch/levels overleaf: <input checked="" type="checkbox"/> Transferred to plan: <input checked="" type="checkbox"/>

Compiled by: <b>POM</b>	Date: <b>2/7/2015</b>	Checked by: <b>2/10/15</b>	Tick when entered in database: <input type="checkbox"/>
----------------------------	--------------------------	-------------------------------	---

Context Number:  
4156

Level No.s 1-3  
TBM 11.40  
B/S 0.97m  
IH 12.37m

Level No.s  
TBM  
B/S  
IH

Level No.s  
TBM  
B/S  
IH

Level No.s  
TBM  
B/S  
IH

No.	F/S	R/L (m OD)	No.	F/S	R/L (m OD)	No.	F/S	R/L (m OD)	No.	F/S	R/L (m OD)
1	1.82	10.55									
2	2.01	10.36									
3	1.81	10.56									

