


Site Code: <b>MNO12</b>	Location: D	Grid Sq: 155/225 155/280	Context Type: MASONRY	Context Number: <del>1125</del> 4194
1. Materials	1. <del>BRICK - red/orange</del> <del>FILE (stone)</del> 2x red 2x orange, 1 FLOOR TILE			
2. Size of materials (brick: BTL in mm)	2. 1 LARGE TILE SLAB: - 0.30m x 0.26m x 50mm			
3. Finish of stones	BRICKS: 240mm x 105mm x 60mm			
4. Coursing / bond	235mm x 95mm x 50mm			
5. Form	4. SINGLE COURSE OF BRICK ON BED BORDERING ONE FLOOR TILE TO SOUTH, EAST + WEST. TILE IS SITTING ON A BED OF MORTAR 25mm THICK			
6. Direction of face(s)	5. POSSIBLE FIRE PLACE INSTALLATION			
7. Surface treatment	6.			
8. Bonding material (if brick: record height of 4 courses & 4 bed joints in m)	7. -			
9. Dimensions of masonry as found	8. MORTAR: LIGHT GREY, CHARCOAL + LIME INCLUSIONS, HARD			
10. Other comments	9. 0.37m N-S, 0.50m E-W, 70mm THICK			
				Max Level: 10.76 m OD
				Min Level: 10.78 m OD

Stratigraphic Relationships:

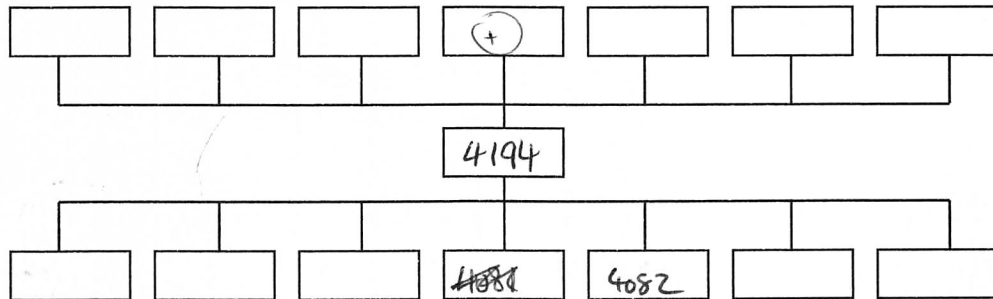

Physical Relationships:

Abuts: [3827]	Abutted by:
Cut by:	

Interpretation:	<u>internal</u>	external
BRICK AND TILE INSTALLATION BUILT AGAINST WALL [3827] IN BETWEEN TWO BRICK PROJECTIONS WHICH ARE THOUGHT TO BE FIRE PLACE RELATED		
Context same as:		

Sample No(s):	Drawing No(s): 4194 (x2)
Photo No(s): M	Sketch/levels overleaf: <input checked="" type="checkbox"/> Transferred to plan: <input checked="" type="checkbox"/>

Compiled by: AB	Date: 3/7/15	Checked by: 7/6/15	Tick when entered in database: <input type="checkbox"/>
--------------------	-----------------	-----------------------	---

Context Number:  
4194

Level No.s  
TBM 11.40  
B/S 0.74  
IH 12.14

Level No.s  
TBM  
B/S  
IH

Level No.s  
TBM  
B/S  
IH

Level No.s  
TBM  
B/S  
IH

No.	F/S	R/L (m OD)	No.	F/S	R/L (m OD)	No.	F/S	R/L (m OD)	No.	F/S	R/L (m OD)
1	1.28	10.86	6	1.33	10.75						
2	1.34	10.80									
3	1.32	10.82									
4	1.36	10.78									
5	1.33	10.82									

