

Site Code: MNO12	Grid Square: 115/200	Context Type: TIMBER	Context Number: T60 2748
1 Type	① PLANK		
2 Setting	② HORIZONTAL SLOPING END TO END, ON BED, NOT INSITU		
3 Orientation	③ <del>NE-SW</del> NE-SW		
4 Cross-Section	④ ELONGATED RECTANGLE		
5 Condition			
6 Dimensions m/mm	⑤ SLIGHTLY ROTTEN BUT GENERALLY OK		
7 Conversion			
8 Tool Marks	⑥ 100mm x 190mm x 20mm		
9 Joints & Fittings			
10 Intentional Marks	⑦ <del>ROUNDED</del> TANGENTIALLY FACED		
11 Surface Treatment			
12 Other Comments			
13 Method & Conditions	⑧ POSSIBLE HALF LAP		
⑩	APPEAR TO BE TWO PARALLEL CURVED INDENTATIONS		
Reuse	Yes:	No:	Unknown:
	POSSIBLY YES		

Interpretation:

LIKELY SECTION OF REURED PLANK WITH NAIL HOLE AND A SQUARED OUT AT ONE END WHICH IS A POSSIBLE OVERLAP FOR JOINING.

2747 2749  
2748

Associated Timbers: T61 T62 T63 T66 T68 T70 ~~T69~~ ~~T71~~ 2762  
Context same as: (2748)


TIMBER CROSS SECTION

Bark: NO

Sapwood: NO

Knotty: NO

Straight-grained: YES

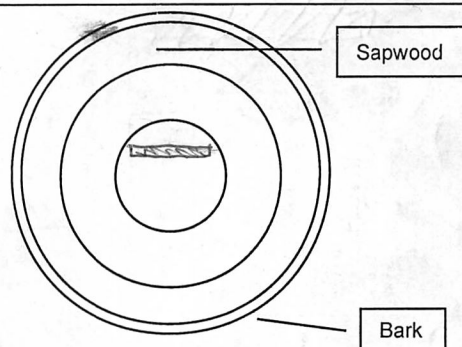

Sample No(s): T60

Drawing No(s): 2748 (x2)

Photo No(s): 4B1-4B2

Sketch/levels overleaf:  Transferred to plan:

Compiled by:

AB

Date:

20/3/15

Checked by:

— 3/1/15

Tick when entered

in database:

Context Number:  
160

Level No.s 1-2  
TBM 9.30  
B/S 0.93  
IH 10.23

Level No.s  
TBM  
B/S  
IH

Level No.s  
TBM  
B/S  
IH

Level No.s  
TBM  
B/S  
IH

No.	F/S	R/L (m OD)	No.	F/S	R/L (m OD)	No.	F/S	R/L (m OD)	No.	F/S	R/L (m OD)
1	2.65	7.58									
2	2.76	7.47									

