


Site Code: MNO12	Location: AREA ①	Grid Sq: 115/215	Context Type: MASONRY	Context Number: 3653
1. Materials	1. BRICK - POSS 3033 - OCCASIONAL TILE USED			
2. Size of materials (brick: BTL in mm)	AS PAVING COURSE			
3. Finish of stones	② LENGTH = 210-230mm WIDTH = 100-110mm			
4. Coursing / bond	THICKNESS = 50-60mm			
5. Form	③ HAND MADE, UNFROGGED (SQUARED MARKS + SUNKEN MARGINS)			
6. Direction of face(s)	④ IRREGULAR ENGLISH BOND FOR NORTH, EAST + WEST WALLS, PREDOMINATELY HEADERS IN SOUTH WALL.			
7. Surface treatment	⑤ CESS PIT.			
8. Bonding material (if brick: record height of 4 courses & 4 bed joints in m)	⑥ N/S, E + W			
9. Dimensions of masonry as found	⑦ NONE OBVIOUS			
10. Other comments	⑧ V. SOFT YELLOWISH GREYISH BROWN SANDY MORTAR, COURSE JOINT = 10-20mm			
	BEDDING COURSE = 15-20mm		Max Level: 10.61 m OD	
	⑨ NS = 1.90m EW = 2.05m		Min Level: 9.18 m OD	
HEIGHT = 1.41m	⑩ WEST WALL - TOP COURSE 4X BRICKS ON SIDE.			

Stratigraphic Relationships:

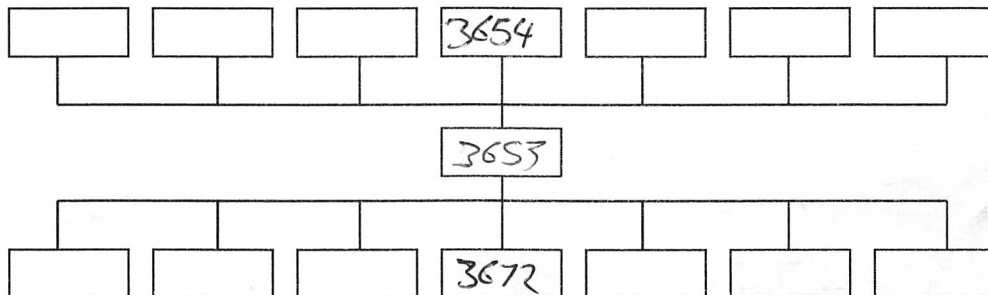

Physical Relationships:

Abuts:	Abutted by:
Cut by: [3393], [3686]	

Interpretation:	internal	external
BRICK CESS PIT, LIKELY PRE-DATES GEORGIAN MINOR DEVELOPMENT. SOUTH AND WEST WALLS ARE THICKER THAN NORTH AND EAST, SOUTH AND WEST WALL HAVE FORMED THE CORNER OF A BUILDING.		
Context same as:		

Sample No(s): 4 BRICKS 2 TILES	Drawing No(s): 3653 (x1)
Photo No(s): 3660 - 3684	Sketch/levels overleaf: <input checked="" type="checkbox"/> Transferred to plan: <input checked="" type="checkbox"/>

Compiled by: PDM + JQ.	Date: 08/06/15	Checked by: a8/10/15	Tick when entered in database: <input type="checkbox"/>
---------------------------	-------------------	-------------------------	---

Context Number:
3653

Level No.s 1-12
TBM 11.40~
B/S 0.93~
IH 12.33~

Level No.s
TBM
B/S
IH

Level No.s
TBM
B/S
IH

Level No.s
TBM
B/S
IH

No.	F/S	R/L (m OD)	No.	F/S	R/L (m OD)	No.	F/S	R/L (m OD)	No.	F/S	R/L (m OD)
1	2.58	9.75~	6	1.92	10.41~	11	3.07	9.26			
2	1.74	10.59~	7	1.95	10.38~	12	3.09	9.24			
3	1.94	10.39~	8	2.83	9.50~						
4	1.72	10.61~	9	3.15	9.18~						
5	2.01	10.32~	10	3.15	9.18~						

