


Site Code: <b>MNO12</b>	Gr. Sq. / TP / Tr: 145/250 145/255	Context Type: DEP	Context Number: 1088
Deposit	① COMPACT	<input checked="" type="checkbox"/> Cut 1. Shape in Plan 2. Corners 3. Dimensions 4. Break of slope - Top 5. Sides 6. Break of slope - Base 7. Base 8. Orientation 9. Inclination 10. Truncation 11. Other comments	
1. Compaction	② MID GREY / BROWN WITH		
2. Colour	PATCHES OF DARK BROWN / BLACK		
3. Composition	AND PATCHES OF BEIGE.		
4. Inclusions	③ CLAYISH SILT WITH GRAVEL		
5. Dimensions	INCLUSIONS.		
6. Other Comments	④ BROKEN CBM, GRAVEL, COAL		
7. Method/Conditions	AND MORTAR FRAGS THROUGHOUT		
	⑤ 0.65m N-S x 0.45m E-W x 0.42m DEEP		
	⑥ BUILT UP AGAINST / DUMPED AGAINST		
	WALLS [1086] AND [1087]		
	<del>PART OF IT MAY HAVE UNDER</del>		
	⑦ MATCH / SMOUL IN GOOD WEATHER		
		Max Level: 10.42m	
		Min Level:	

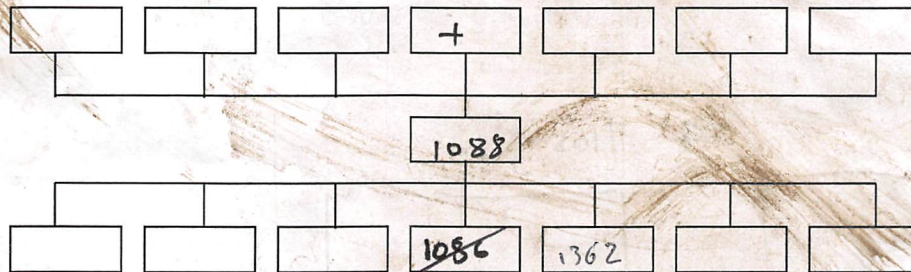

Interpretation:	DUMP OF BUILDING DETRITUS / EXCAVATED GRAVEL
	WITHIN FOUNDATION TRENCH FOR <del>WALL</del> WALLS [1086] + [1087]
	TRUNCATED TO E BY FOUNDATION CUT OF LATE WALL.
	VERY MIXED - BROKEN CBM AND BRICK DUST / MORTAR
	THROUGHOUT MIXED WITH DIRTY GRAVEL, SILT AND CLAY.
	SOME MAY GO UNDER WALL - A BEDDING LAYER
	FOR LEVELLING THE FOUNDATIONS OF THE WALL MADE OF
	THE SAME MATERIAL THAT IS THEN THROWN BACK
	IN AFTER WALL HAS BEEN BUILT.
	CONSTRUCTION BACKFILL.
Context same as:	

Finds: None <input type="checkbox"/> Pot <input checked="" type="checkbox"/> Bone <input checked="" type="checkbox"/> Glass <input type="checkbox"/> Metal <input checked="" type="checkbox"/> CBM <input type="checkbox"/> Flint <input type="checkbox"/> Wood <input type="checkbox"/> Leather <input type="checkbox"/>	
Other (specify): CTP	
Sample No(s):	Drawing No(s): (x)
Photo No(s): -	Sketch/levels overleaf: <input checked="" type="checkbox"/> Transferred to plan: <input checked="" type="checkbox"/>

Compiled by: BSS	Date: 20/11/14	Checked by: a 26/3/15	Tick when entered in database: <input type="checkbox"/>
---------------------	-------------------	--------------------------	---

Context Number:  
1088


Level No.s  
TBM 10.29m  
B/S 1.94m  
IH 12.23m

Level No.s  
TBM  
B/S  
IH

Level No.s  
TBM  
B/S  
IH

Level No.s  
TBM  
B/S  
IH

No.	F/S	R/L (m OD)	No.	F/S	R/L (m OD)	No.	F/S	R/L (m OD)	No.	F/S	R/L (m OD)
1	1.81	10.42.									

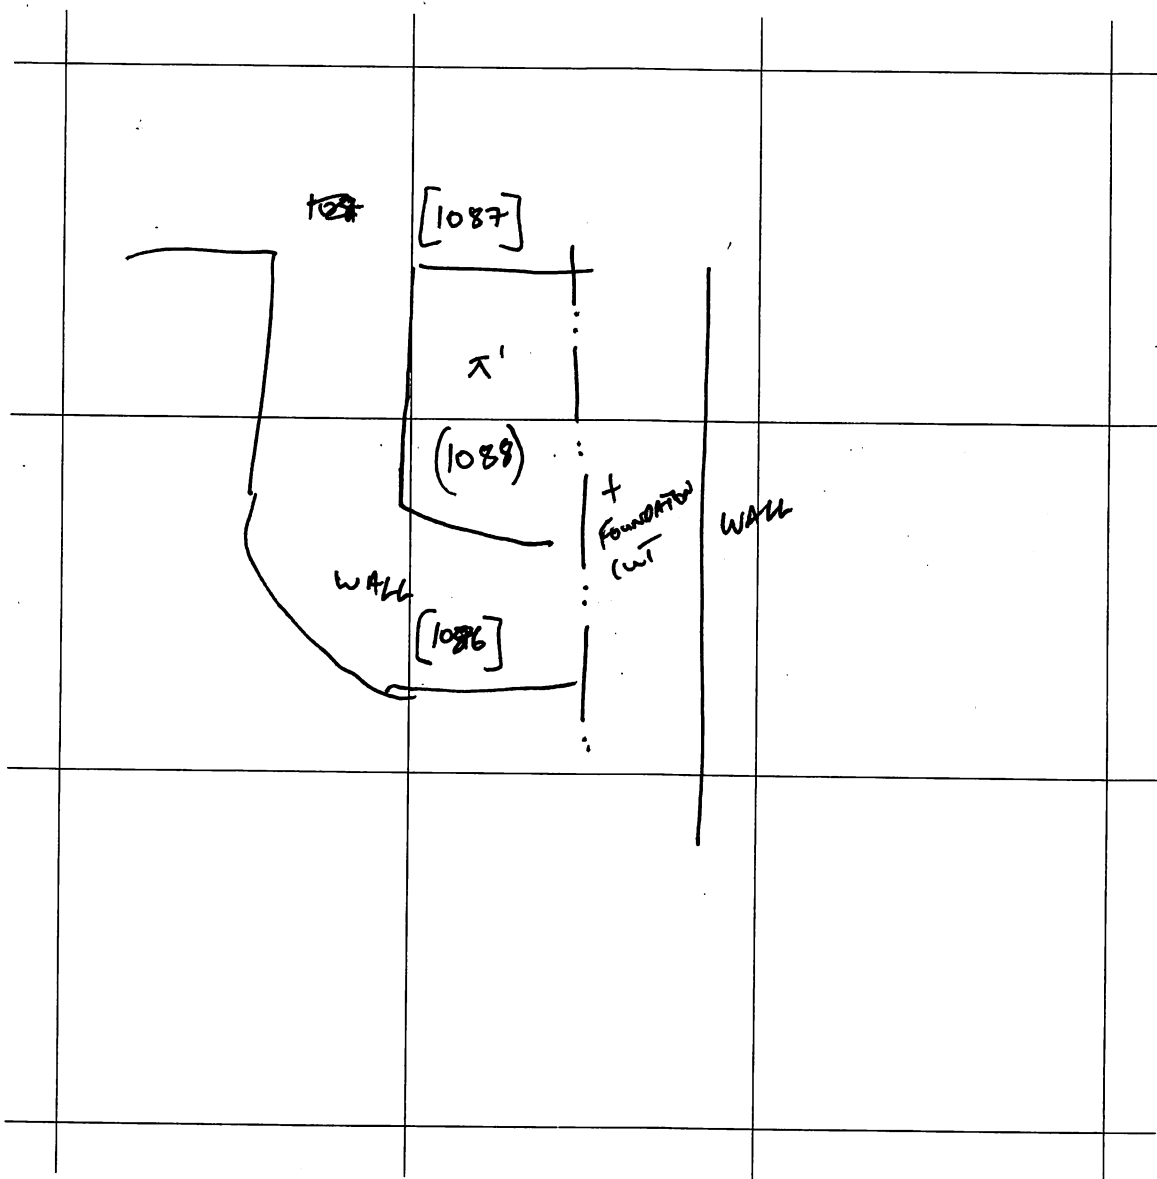

Sketch Plan & Notes