


Site Code: MNO-12	Grid Square: TP 1	Context Type: Fill	Context Number: 33
Deposit	1. SOFT	Cut 1. Shape in Plan 2. Corners 3. Dimensions 4. Break of slope - Top 5. Sides 6. Break of slope - Base 7. Base 8. Orientation 9. Inclination 10. Truncation 11. Other comments	
1. Compaction	2. MID-DARK BLACK		
2. Colour	3. SILTY CLAY.		
3. Composition	4. <del>SEE PORTION KEY BRICK FRAG, OCC. YELLOW</del>		
4. Inclusions	5. <del>SEE BRICK FRAG</del>		
5. Dimensions	6. Lined with black pill.		
6. Other Comments	7. 0.96 x 0.4 x 0.14 ~ thick.		
7. Method/Conditions	8. Truncated to east by [38]		
			made 10.62
			in 10.50

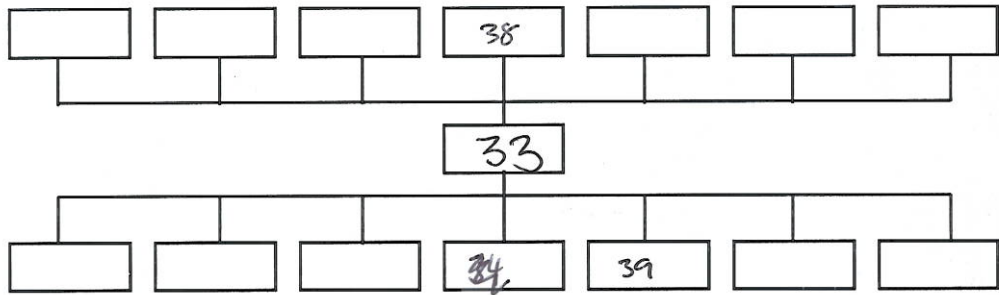

Interpretation:

Dark fill of brick-lined cesspit, prob cess material, no sample due to contamination by modern and 18th/19th C disturbances.

SITING UP OF DRAIN WITH CESSY SILT

Context same as:

Finds: None  Pot  Bone  Glass  Metal  CBM  Flint  Wood  Leather

Other (specify):

Sample No(s):

Photo No(s):

Drawing No(s): — (x—) 5.4

Sketch/levels overleaf:


Transferred to plan:

Compiled by: on

Date: 21/8/12

Checked by: on 3/2/12

Tick when entered in database:

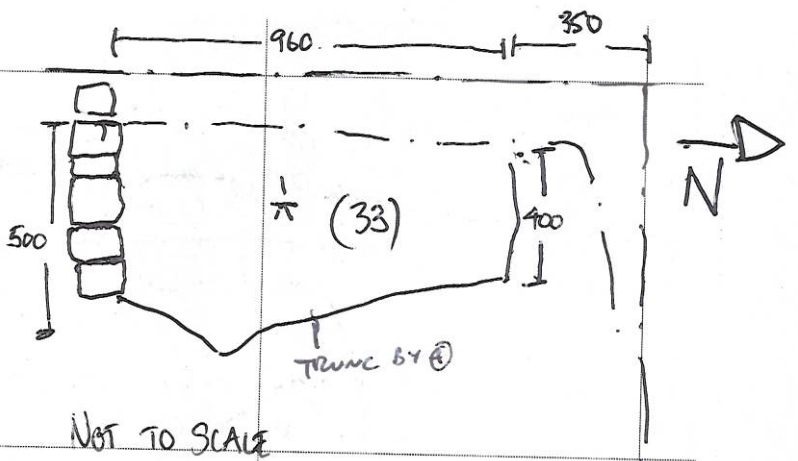

NOT TO SCALE

TBM 13-69  
 BS 1-83  
 IH 15-52

NW Corner BS 3-52  
 SW Corner BS 3-52

FS  
 $\frac{1}{\pi} \quad 3.52 + 1.50 = 5.02$   
 $34 \left( \frac{2}{\pi} \quad 3.52 + 1.38 = 4.90 \right)$

RL (MOP)  
 10.50  
 10.62

350 S.  
 960 NW  
 400 500.

Sketch Plan & Notes

L-P:ARCHAEOLOGY