


Site Code: <b>MNO12</b>	Gr. Sq. / TP / Tr: <b>A 1501255.</b>	Context Type: <b>MASONRY</b>	Context Number: <b>1092</b>
1. Materials	① <b>RED BRICK, RED/PURPLE BRICK</b>		
2. Size of materials (brick: BTL in mm)	ORANGE/ <b>60mm 90mm 90mm 60mm 130mm</b>		
3. Finish of stones	② <b>BETWEEN 90mm x 90mm x 60mm AND 130mm x 90mm x 60mm</b>		
4. Coursing / bond	③ <b>RECTANGULAR AND SQUARE → HALF BATS, HAND MADE, NO FROGGING.</b>		
5. Form	④ <b>STRETCHERS HALF BATS ON EDGE.</b>		
6. Direction of face(s)	⑤ <b><del>DRAIN</del> BRICK DRAIN.</b>		
7. Bonding material (if brick: record height of 4 courses & 4 bed joints in m)	⑥ <b>NORTH-SOUTH. UP.</b>		
8. Dimensions of masonry as found	⑦ <b>SINGLE COURSE IN HEIGHT, TWO TYPES OF SILTY BONDING MATERIAL. THE FIRST IS MID ORANGE GREY, FRIABLE, WITH SMALL STONES (10-15mm), FALLS APART EASILY.</b>		
9. Other comments	⑧ <b>1.13m (E-W) x 0.32m (N-S) x 0.08m (HEIGHT).</b>		
	⑨ <b>TRUNCATED ON <del>EASTERN</del> WESTERN EXTENT BY MODERN CONCRETE AND ON EASTERN EXTENT BY MODERN CONSTRUCTION CUT.</b>		
<b>HEAVILY DAMAGED BY MODERN ACTIVITY, ONLY BASE OF DRAIN SURVIVING.</b>			
⑩ <b>CONTINUED... THE SECOND IS MID BLACKISH GREY, FRIABLE, SMALL STONES (2-6mm). A LOT</b>			

Stratigraphic Relationships: **SILTIER AS IT STAYS TOGETHER - CAN BE ROLLED INTO A BALL.**

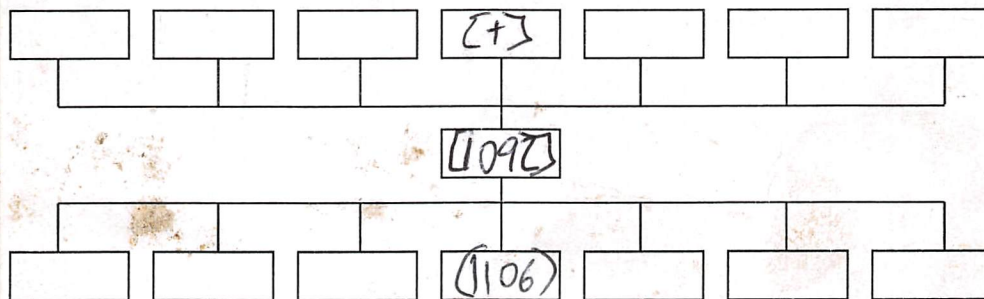

Physical Relationships:

Abuts:	Abutted by:
Cut by: <b>MODERN [+] CONSTRUCTION CUTS ON EASTERN AND WESTERN EXTENTS.</b>	

Interpretation:	internal	external
<b>REMAINS OF BRICK DRAIN. ONLY BASE SURVIVING. BRICKS ARE ON FLAT EDGE IN CENTRE AND <del>ARE</del> ON MORE OF AN ANGLE TOWARDS THE CENTRE <del>AS THEY</del> IN THE EXTERIOR POSITIONS.</b>		
<b>THIS IS BELIEVED TO REPRESENT A CIRCULAR DRAIN STRUCTURE WITH A STRETCHER COURSING.</b>		
<b>SITS WITHIN A CONSTRUCTION CUT.</b>		
Context same as:		

Sample No(s): <b>2 x BRICK SAMPLE</b>	Drawing No(s): <b>1092 (x 1)</b>
Photo No(s): <b>1345, 1346</b>	Sketch/levels overleaf: <input checked="" type="checkbox"/> Transferred to plan: <input checked="" type="checkbox"/>

Compiled by: <b>TD</b>	Date: <b>21/11/14.</b>	Checked by: <b>a s l / 15.</b>	Tick when entered in database: <input type="checkbox"/>
---------------------------	---------------------------	-----------------------------------	---

Context Number:

1092

Level No.s 1-10

Level No.s

Level No.s

Level No.s

TBM 10-29

TBM

TBM

TBM

B/S 1.78

B/S

B/S

B/S


IH 1207

IH

IH

IH

No.	F/S	R/L (m OD)	No.	F/S	R/L (m OD)	No.	F/S	R/L (m OD)	No.	F/S	R/L (m OD)
1	1.61	10.46	6	1.58	10.49						
2	1.59	10.48	7	1.56	10.51						
3	1.58	10.49	8	1.66	10.41						
4	1.65	10.42	9	1.63	10.44						
5	1.56	10.51	10	1.87	10.40						

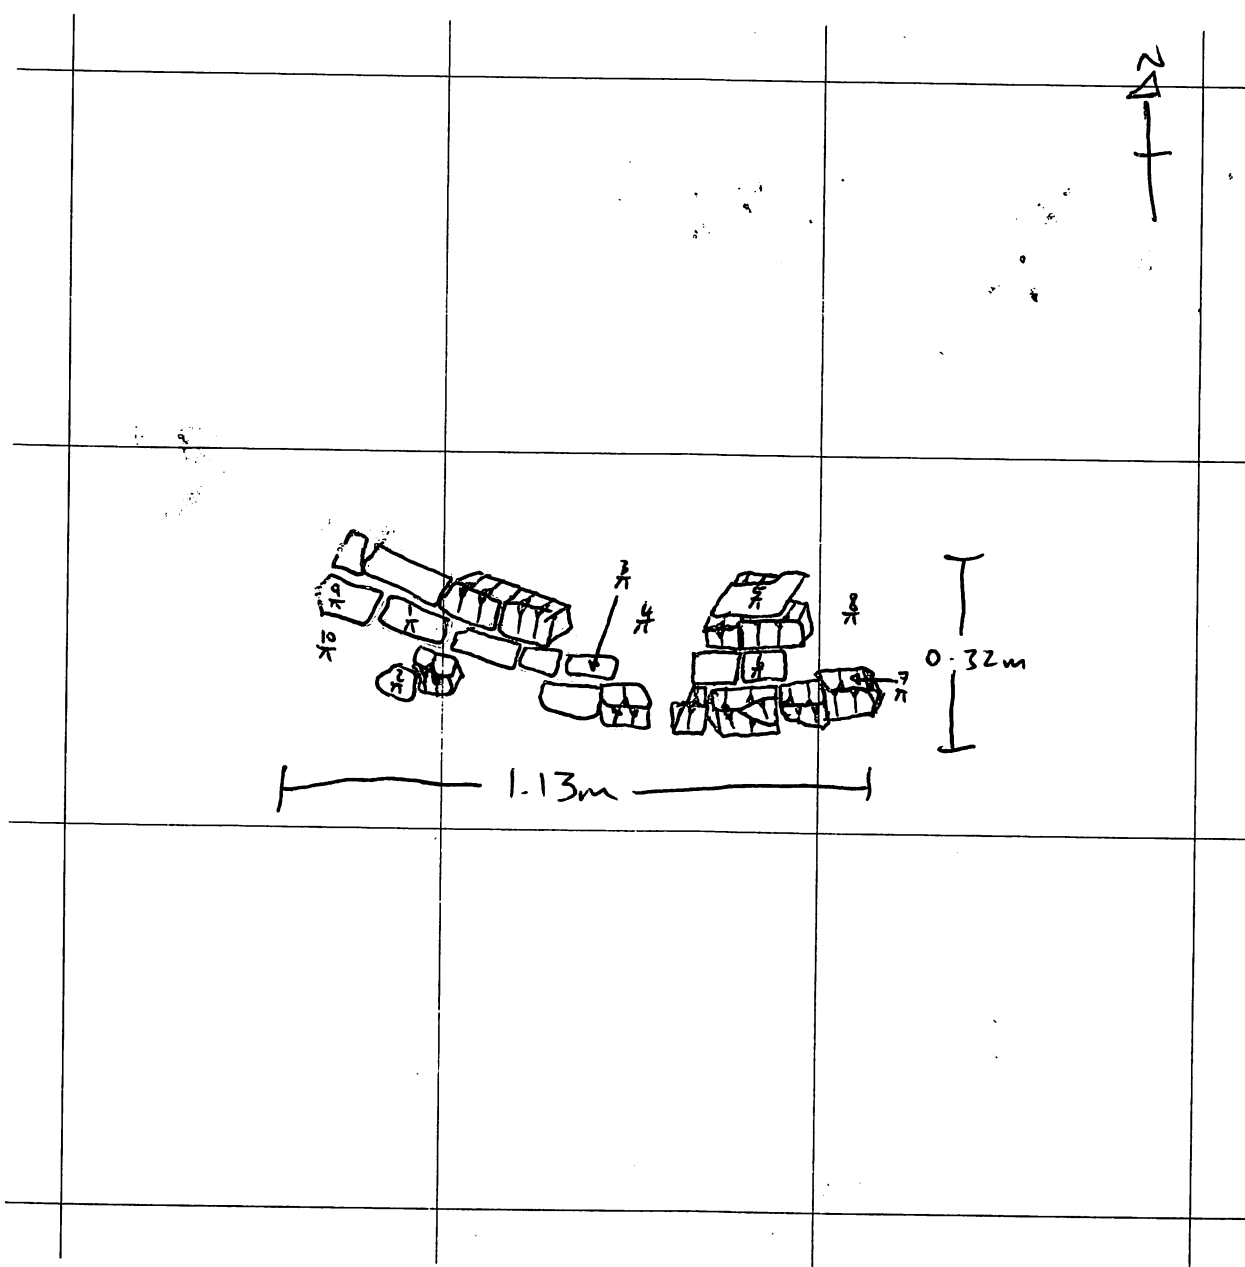

Sketch Plan &amp; Notes

L-P:ARCHAEOLOGY