


|   |  |                                      |                                 |                                |
|---|--|--------------------------------------|---------------------------------|--------------------------------|
| Site Code:<br><b>MNO12</b>  | Location:<br><b>B</b>  | Grid Sq:<br><b>120/215 - 130/215</b> | Context Type:<br><b>MASONRY</b> | Context Number:<br><b>2711</b> |
| 1. Materials  | ① BRICK, PEPTILE, MORTAR   |                                      |                                 |                                |
| 2. Size of materials<br>(brick: BTL in mm)  | ② 230mm x 110mm x 60mm COMPLETE. OCCASIONAL<br>VARIABLE 260mm x 120mm<br>PEPTILE<br>HALF BRICKS ALONG EDGE.                    |                                      |                                 |                                |
| 3. Finish of stones   | ③ HAND MADE RED BRICKS   |                                      |                                 |                                |
| 4. Coursing / bond  | ④ PEPTILE<br><del>BRICK</del> AT BASE OF BED N-S, 2 BRICKS ON<br>BED E-W AS SIDES, 1 BRICK ON BED N-S AS<br>TOP - SEE REVERSE. |                                      |                                 |                                |
| 5. Form   |  |                                      |                                 |                                |
| 6. Direction of face(s)   | ⑤ BRICK DRAIN  |                                      |                                 |                                |
| 7. Surface treatment  | ⑥ N-S  |                                      |                                 |                                |
| 8. Bonding material<br>(if brick: record height<br>of 4 courses & 4 bed<br>joints in m) | ⑦ -  |                                      |                                 |                                |
| 9. Dimensions of<br>masonry as found  | ⑧ VERY BRITTLE / FRIABLE PALE YELLOW<br>VERY SANDY MORTAR.   |                                      |                                 |                                |
| 10. Other comments  | ⑨ <del>200mm</del> 0.35m WIDE x 0.2m DEEP x 15.25m LONG. E-W   |                                      | Max Level:                      | m OD                           |
|   | ⑩ IN PHASES NO UPPER BRICKS  |                                      | Min Level:                      | m OD                           |
| ARE PRESENT - REMAINS OF TIMBER PLANK INSTEAD   |  |                                      |                                 |                                |

Stratigraphic Relationships:

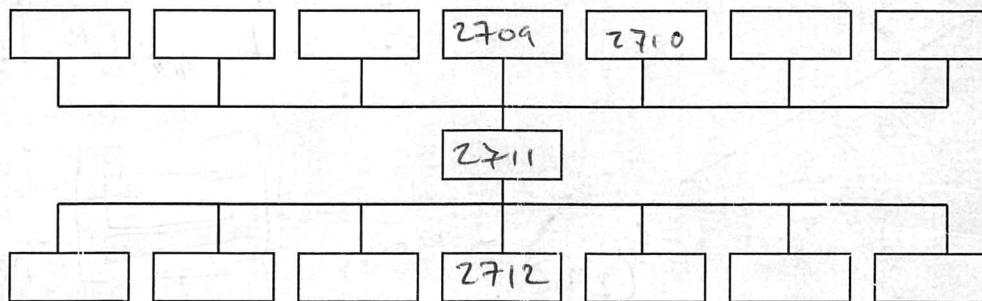

Physical Relationships:

|                                |             |
|--------------------------------|-------------|
| Abuts:                         | Abutted by: |
| Cut by: <b>[242] SEWER CUT</b> |             |

|  |          |          |
|--|----------|----------|
| Interpretation:  | internal | external |
| SQUARE SECTION DRAIN RUNNING DOWN PRESUMABLY<br>FROM HOUSES ON MINORIES FRONTAGE DOWN<br>TO <del>THE</del> PITCH AT W END OF SITE. FOR<br>EFFLUENT / WASTE |          |          |

SOME BRICKS ON 'ROOF' OF DRAIN SHOW EVIDENCE OF REUSE WITH REMAINS OF MORTAR

Context same as:

|               |   |
|---------------|---|
| Sample No(s): | Drawing No(s): <b>2711 (x 4)</b>  |
| Photo No(s):  | Sketch/levels overleaf: <input type="checkbox"/><br>Transferred to plan: <input type="checkbox"/> |

|                            |                         |                                |   |
|----------------------------|-------------------------|--------------------------------|---|
| Compiled by:<br><b>BSS</b> | Date:<br><b>16/3/15</b> | Checked by:<br><b>27/10/15</b> | Tick when entered in database: <input type="checkbox"/> |
|----------------------------|-------------------------|--------------------------------|---|

Context Number:  
2711

Level No.s 1-35  
TBM 9.30  
B/S 0.38  
IH 9.68


Level No.s 36-39  
TBM 9.30  
B/S 0.36  
IH 9.66

Level No.s 40-45  
TBM 9.30  
B/S 0.90  
IH 10.20

Level No.s ~~44-45~~  
TBM  
B/S  
IH

| No. | F/S  | R/L (m OD) | No. | F/S  | R/L (m OD) | No. | F/S  | R/L (m OD) | No. | F/S      | R/L (m OD) |
|-----|------|------------|-----|------|------------|-----|------|------------|-----|----------|------------|
| 1   | 0.47 | 9.21       | 6   | 0.77 | 8.91       | 11  | 0.94 | 8.74       | 16  | 1.22     | 8.46       |
| 2   | 0.55 | 9.013      | 7   | 0.75 | 8.93       | 12  | 0.90 | 8.78       | 17  | 1.35     | 8.33       |
| 3   | 0.56 | 9.14       | 8   | 0.82 | 8.86       | 13  | 1.04 | 8.59       | 18  | 1.31     | 8.37       |
| 4   | 0.60 | 9.03       | 9   | 0.83 | 8.85       | 14  | 1.05 | 8.63       | 19  | 1.40     | 8.20       |
| 5   | 0.70 | 8.98       | 10  | 0.88 | 8.80       | 15  | 1.03 | 8.60       | 20  | NOT USED |            |

|    |      |      |    |      |      |    |      |      |    |      |        |    |      |      |
|----|------|------|----|------|------|----|------|------|----|------|--------|----|------|------|
| 21 | 1.63 | 8.05 | 25 | 1.86 | 7.82 | 30 | 2.18 | 7.50 | 35 | 1.49 | 8.19   | 42 | 3.00 | 7.20 |
| 22 | 1.70 | 7.98 | 26 | 1.94 | 7.74 | 31 | 2.12 | 7.56 | 36 | 0.65 | 9.01   |    |      |      |
| 23 | 1.74 | 7.94 | 27 | 2.08 | 7.60 | 32 | 2.20 | 7.48 | 37 | 0.93 | 9.8.83 | 43 | 3.00 | 7.20 |
| 24 | 1.82 | 7.86 | 28 | 2.01 | 7.67 | 33 | 0.72 | 8.96 | 38 | 1.11 | 9.55   |    |      |      |
|    |      |      | 29 | 2.07 | 7.61 | 34 | 1.07 | 8.61 | 39 | 1.43 | 8.23   | 44 | 3.11 | 7.09 |
|    |      |      |    |      |      |    |      |      | 40 | 3.01 | 7.19   |    |      |      |
|    |      |      |    |      |      |    |      |      | 41 | 2.95 | 7.05   | 45 | 3.13 | 7.07 |

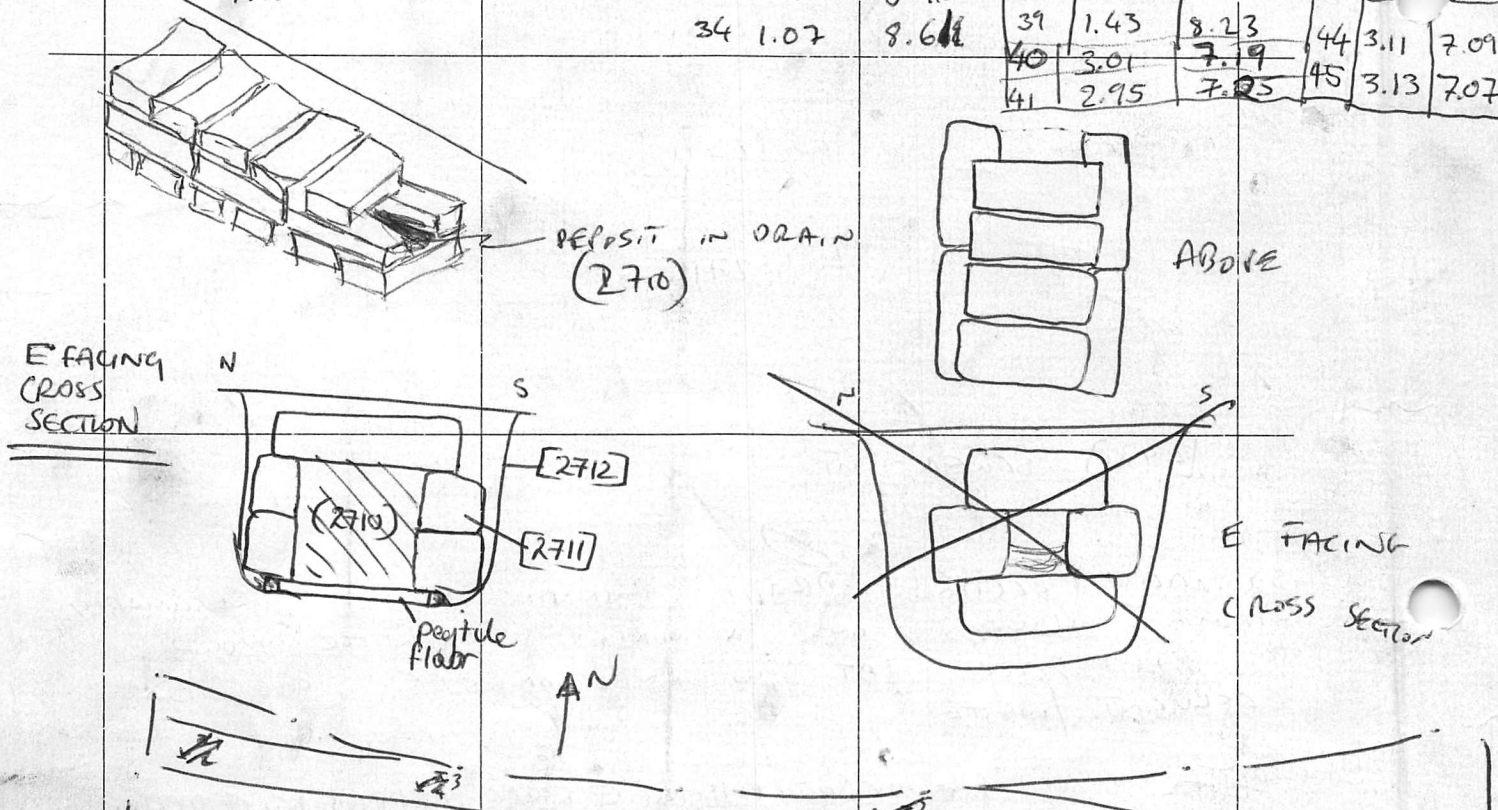

SEE PLAN FOR LEVEL POSITIONING

NOTE: LEVELS 36 - ARE ON TOP OF PEG TILES - BASE OF DRAIN. FROM E-W. SHOWING FALL.