


Site Code: <b>MNO12</b>	Location: <b>B</b>	Grid Sq: <b>120/210</b>	Context Type: <b>DEP</b>	Context Number: <b>2337</b>
Deposit 1. Compaction 2. Colour 3. Composition 4. Inclusions 5. Interface 6. Dimensions 7. Other Comments 8. Method/Conditions	① LOOSE ② MID/DARK LAYERED BROWN <del>WITH FREQUENT ANNUAL</del> ③ SANDY SILT ④ FREQUENT ANNUAL YOLKSTONE FRAGS 20-180mm FREQUENT SLATE + MORTAR FRAGS 5mm-25mm Text			<del>Cut</del> 1. Shape in Plan 2. Corners 3. Dimensions 4. Break of slope - Top 5. Sides 6. Break of slope - Base 7. Base 8. Orientation 9. Inclination 10. Truncation 11. Other comments
	⑤			
	⑥			
				Max Level: 11.03 m OD
				Min Level: 10.43 m OD

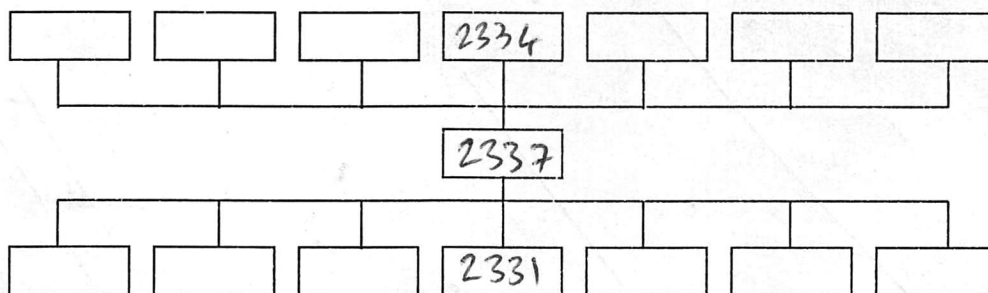


Interpretation:	<u>Internal</u>	External	Structural
CONSTRUCTION BACKFILL WITHIN CHURCH SILENT			
TRAP FOR CERAMIC PIPE DRAIN			
FILLED WITH GENERAL CONSTRUCTION RUBBISH			
Context same as:			

Finds: None <input type="checkbox"/> Pot <input type="checkbox"/> Bone <input type="checkbox"/> Glass <input type="checkbox"/> Metal <input type="checkbox"/> CBM <input type="checkbox"/> Flint <input type="checkbox"/> Wood <input type="checkbox"/> Leather <input type="checkbox"/>	
Other (specify):	
Sample No(s):	Drawing No(s): (x)
Photo No(s):	Sketch/levels overleaf: <input type="checkbox"/> Transferred to plan: <input type="checkbox"/>

Compiled by: RSS CH	Date: 23/1/15	Checked by: a 4/1/15	Tick when entered in database: <input type="checkbox"/>
------------------------	------------------	-------------------------	---

# L-P:ARCHAEOLOGY

Sketch Plan & Notes

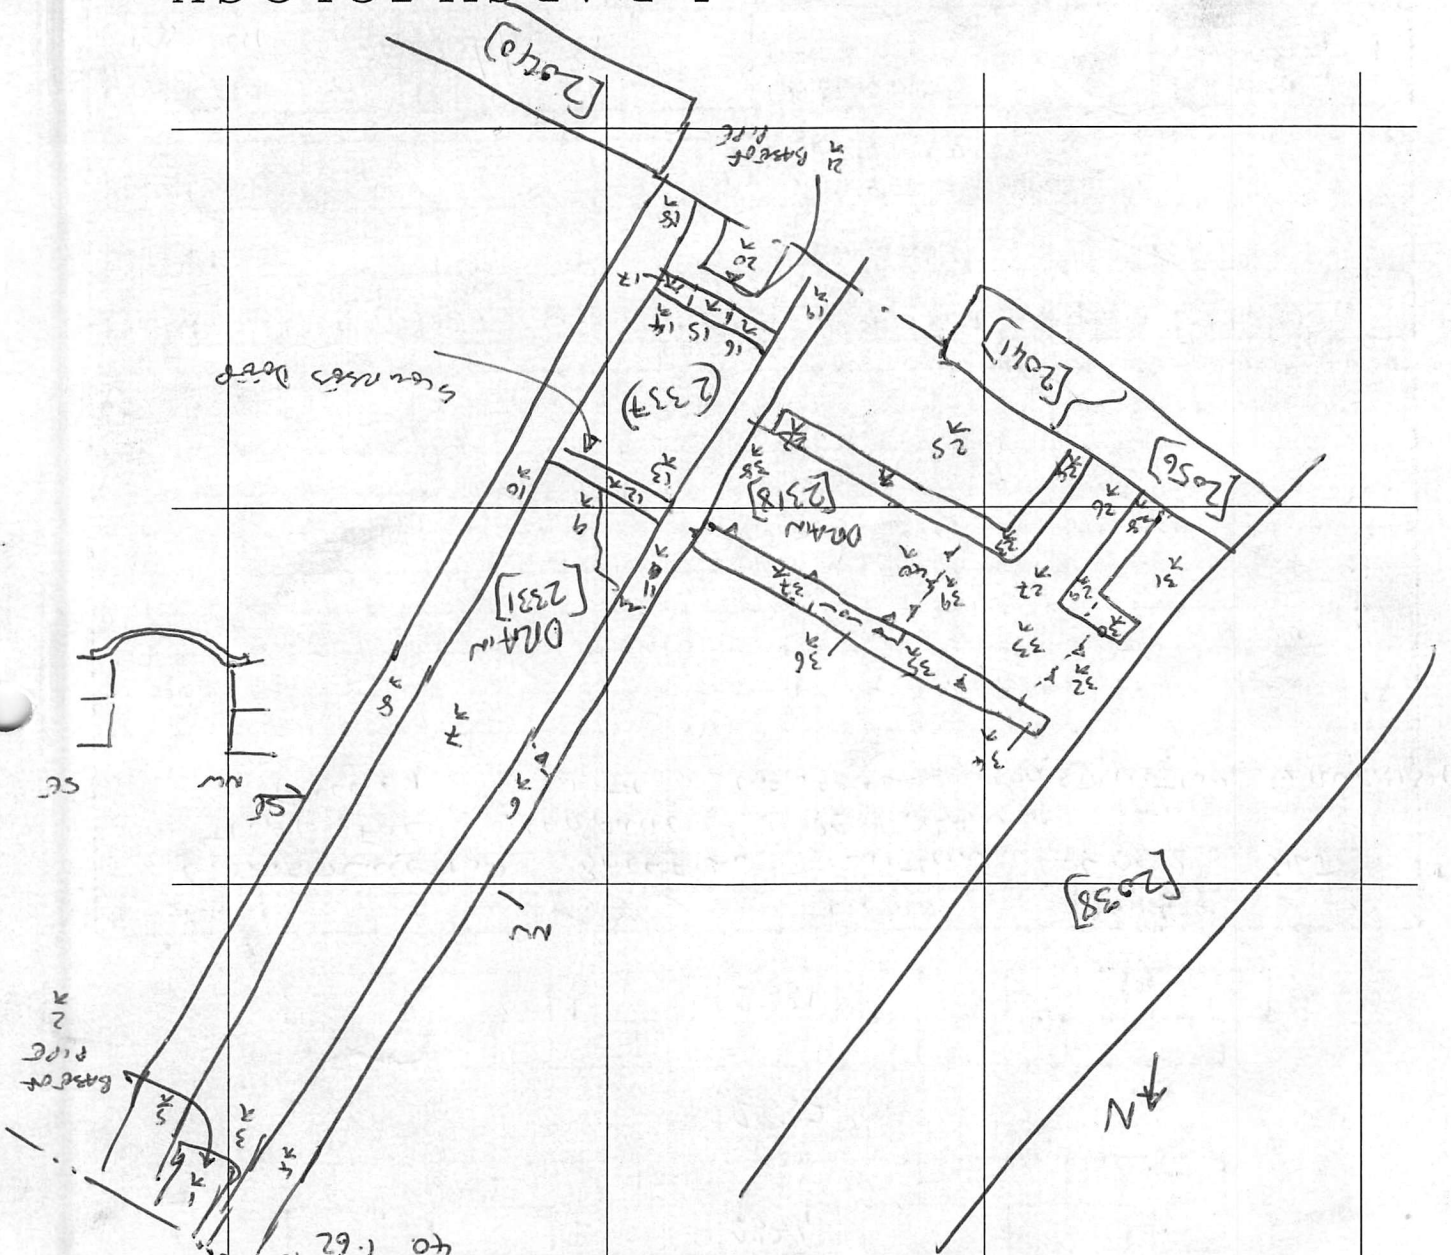

No.	F/S	R/L (m OD)	No.	F/S	R/L (m OD)	No.	F/S	R/L (m OD)	No.	F/S	R/L (m OD)
1	F/S	10.97	6	F/S	11.02	11	F/S	10.99	16	F/S	10.88
2	F/S	10.85	7	F/S	10.83	12	F/S	10.82	17	F/S	10.93
3	F/S	10.82	8	F/S	11.03	13	F/S	10.42	18	F/S	10.99
4	F/S	11.00	9	F/S	10.84	14	F/S	10.43	19	F/S	10.98
5	F/S	11.38	10	F/S	11.36	15	F/S	10.73	20	F/S	10.94
21	F/S	10.83	26	F/S	10.84	31	F/S	10.73	35	F/S	10.95
22	F/S	10.94	27	F/S	10.83	32	F/S	10.70	36	F/S	10.99
23	F/S	10.43	28	F/S	10.90	33	F/S	10.78	37	F/S	10.94
24	F/S	11.44	29	F/S	10.94	34	F/S	10.82	38	F/S	10.84
25	F/S	11.44	30	F/S	10.82	35	F/S	10.81	39	F/S	10.81
40	F/S	10.76	40	F/S	10.76	40	F/S	10.76	40	F/S	10.76

Level No.s  
 TBM 11.68 m OD  
 B/S 0.70  
 IH 12.38 m OD

Level No.s  
 TBM  
 B/S  
 IH

Level No.s  
 TBM  
 B/S  
 IH

Context Number: 2337