


Site Code: MNO12	Location: AREA B	Grid Sq: 115/205	Context Type: MASONRY	Context Number: 2202
1. Materials				
2. Size of materials (brick: BTL in mm)	1. the york stone slab + brick (red hard brick) lining			
3. Finish of stones	2. 0.66m x 0.50m york stone slab (0.66m (N-S), 0.50m (E-W); 0.05m thick)			
4. Coursing / bond	Bricks - varying in size (0.10m 100mm x 120mm x 50mm in average)			
5. Form	3. worked, but not smoothed			
6. Direction of face(s)	4. /			
7. Surface treatment	5. cesspool cover			
8. Bonding material (if brick: record height of 4 courses & 4 bed joints in m)	6. N/A			
9. Dimensions of masonry as found	7. worked, but not smooth (sandy)			
10. Other comments	8. mid-yellowish brown with mod. friable mortar with mod. stone incl. (2-10mm)			
	9. 1.05m (E-W), 0.76m (N-S), 0.05m thick (york stone) 0.13m thick (york stone + brick lining)			
				Max Level: 11.38 m OD
				Min Level: 11.30 m OD

Stratigraphic Relationships:

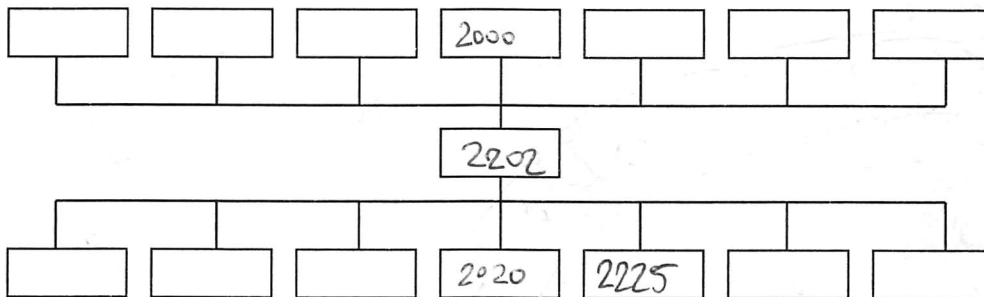

Physical Relationships:

Abuts: 2010	Abutted by:
Cut by:	

Interpretation:	internal	<u>external</u>
york stone stone slab in cesspool [2010]		
The slab was placed on to two structures, [2020] and [2225].		
L-shaped structure was [2000] was built on top of it		
The purpose of the slab was - it was a lid-cover.		
Context same as:		

Sample No(s):	Drawing No(s): 2202 (x 1)
Photo No(s): 2593-95, 2598, 2599	Sketch/levels overleaf: <input checked="" type="checkbox"/> Transferred to plan: <input checked="" type="checkbox"/>

Compiled by: MK	Date: 21-01-2015	Checked by: a. 13/5/15.	Tick when entered in database: <input type="checkbox"/>
--------------------	---------------------	----------------------------	---

Context Number:
2202

Level No.s 1-6
TBM 11.68
B/S 0.76
IH 12.44 m OD

Level No.s
TBM
B/S
IH

Level No.s
TBM
B/S
IH

Level No.s
TBM
B/S
IH

No.	F/S	R/L (m OD)	No.	F/S	R/L (m OD)	No.	F/S	R/L (m OD)	No.	F/S	R/L (m OD)
1	1.06	11.38	6	1.14	11.30						
2	1.14	11.30									
3	1.13	11.31									
4	1.08	11.36									
5	1.06	11.38									

