


Code: MNO12	Location: AREA B	Grid Sq: 130-135 / 205	Context Type: MASONRY	Context Number: 2170
1. Materials	1. RED BRICK , PURPLISH RED / YELLOW BRICK .			
2. Size of materials (brick: BTL in mm)	2. WHOLE, HALF + 3/4 2 100 x 65 x 225			
3. Finish of stones	3. -			
4. Coursing / bond	4. ENGLISH - ROUGHEN .			
5. Form	5. LIGHT WELL .			
6. Direction of face(s)	6. INTERIOR WALL FACES EAST AND SOUTH .			
7. Surface treatment	7. SEVERABLY NEAT POINTING ON INTERIOR WALL SOME COVERING			
8. Bonding material (if brick: record height of 4 courses & 4 bed joints in m)	8. REBUILD (2171) MORTAR, SOUTH-FACING ELEVATION HAS THIN COATING OF CHARCOAL (?)			
9. Dimensions of masonry as found	9. LIGHT GREY CHALKY LIMB MORTAR W V. DL CHARCOAL FLESH - MOD HARD/BENTLE, 4 COURSES 330 MM			
10. Other comments	9. 2.25 m N/S x 0.90 m E/W, WALL 350 mm THICK			
				Max Level: 11.83 m OD
				Min Level: 10.55 m OD

Stratigraphic Relationships:

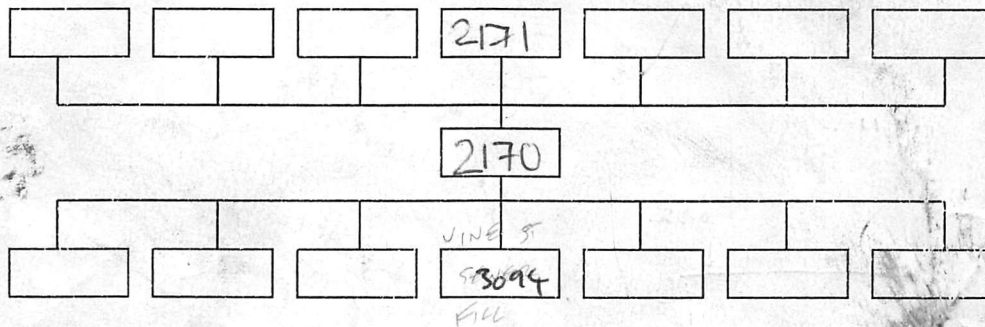

Physical Relationships:

Abuts:	Abutted by: 2171
Cut by:	

Interpretation:	internal	<u>external</u>
LIGHT WELL WALL - 'C' CHARCOAL UNDER EAST SIDE VINE ST.		
INTERNAL REBUILD (2171) INSIDE LIGHT WELL.		
RELATIONSHIP TO VINE STREET SEWER CUT UNCERTAIN 22/1/11.		
DAMAGED TO E. LOWEST LEVEL: 10.55M		
Context same as:		

Sample No(s): 2743-2751 2Y BRICK.	Drawing No(s): 2170 (x2)
Photo No(s): 2743-2751	Sketch/levels overleaf: <input type="checkbox"/>
	Transferred to plan: <input type="checkbox"/>

Compiled by:	Date: 20/1/15	Checked by: 27/1/15	Tick when entered in database: <input type="checkbox"/>
--------------	----------------------	----------------------------	---

Context Number:
2170

Level No.s 1-3
TBM 11.68
B/S 0.79
IH 12.47


Level No.s 4
TBM ~~11.80~~ 11.80
B/S ~~0.72~~ 0.16
IH 11.64

Level No.s
TBM
B/S
IH

Level No.s
TBM
B/S
IH

No.	F/S	R/L (m OD)	No.	F/S	R/L (m OD)	No.	F/S	R/L (m OD)	No.	F/S	R/L (m OD)
1	0.64	11.83									
2	1.11	11.36									
3	1.81	10.66									
4	1.09	10.55									

SKETCH PLAN

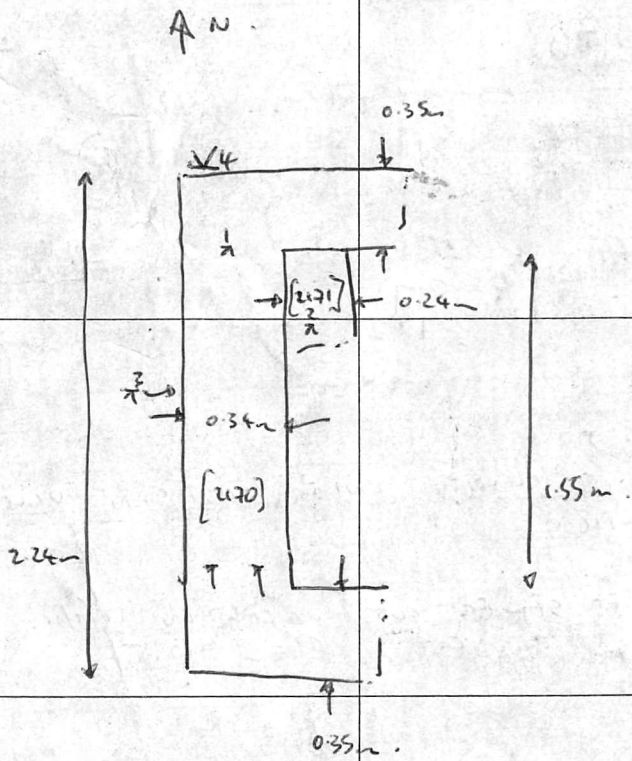

LEVEL
3/2 IS AT BASE OF EXCAVATION, NOT BASE OF WALL