


Site Code: <b>MNO12</b>	Location: AREA B	Grid Sq: 110/210	Context Type: MASONRY	Context Number: [2145]
1. Materials				
2. Size of materials (brick: BTL in mm)	1. red brick + occa tile			
3. Finish of stones	2. bricks are varying in size (140mm x 60mm x 90mm in average)			
4. Coursing / bond	3. NA			
5. Form	4. irregular			
6. Direction of face(s)	5. blocking off of drain (2022)			
7. Surface treatment	6. E; W			
8. Bonding material (if brick: record height of 4 courses & 4 bed joints in m)	7. - → very hard mid grey mortar			
9. Dimensions of masonry as found	8. <del>No bonding</del> no bonding material; NA			
10. Other comments	9. 0.40m (N-S); 0.30m (E-W), 0.31m (height)			
	10. /			
				Max Level: 11.05 m OD
				Min Level: 10.74 m OD

Stratigraphic Relationships:

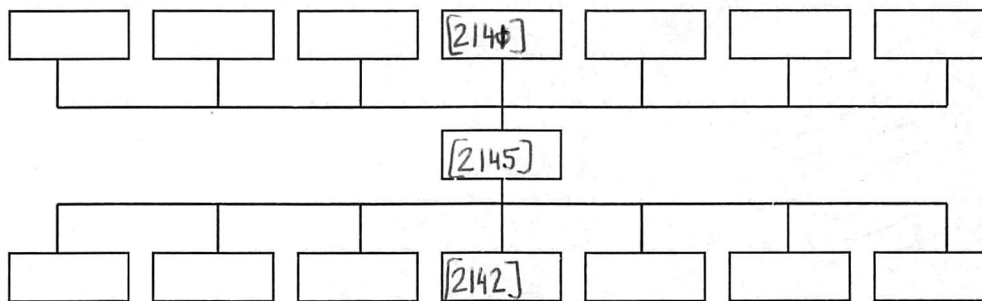

Physical Relationships:

Abuts:	Abutted by:
Cut by:	

Interpretation:	internal	<u>external</u>
Intentional blocking off of drain [2022] with bricks, <del>bonding</del> mortar and occa. tile.		
Context same as:		

Sample No(s):	Drawing No(s): / (x )
Photo No(s): <del>2505, 2506</del>	Sketch/levels overleaf: <input checked="" type="checkbox"/> Transferred to plan: <input checked="" type="checkbox"/>

Compiled by: MK	Date: 19-01-2015	Checked by: a 23/1/15	Tick when entered in database: <input type="checkbox"/>
--------------------	---------------------	--------------------------	---

Context Number:  
2145

Level No.s 1-2  
TBM 11.68m  
B/S 0.60  
IH 12.28

Level No.s  
TBM  
B/S  
IH

Level No.s  
TBM  
B/S  
IH

Level No.s  
TBM  
B/S  
IH

No.	F/S	R/L (m OD)	No.	F/S	R/L (m OD)	No.	F/S	R/L (m OD)	No.	F/S	R/L (m OD)
1	1.23	11.05									
2	1.54	10.74									

