


Site Code: <b>MNO12</b>	Location: <i>Area B.</i>	Grid Sq: <i>120/205</i>	Context Type: <b>MASONRY</b>	Context Number: <b>2316</b>
1. Materials	<i>1. Red and orangeish bricks</i>			
2. Size of materials (brick: BTL in mm)	<i>2. 95 mm x 225 mm x 60 mm but other sizes have been observed for brick.</i>			
3. Finish of stones	<i>(235 x 100 x 70 mm)</i>			
4. Coursing / bond	<i>3. Moulded brick</i>			
5. Form	<i>4. white grey mortar well sorted with very fine inclusions of brick flecks</i>			
6. Direction of face(s)	<i>5. <del>rectangular</del></i>			
7. Surface treatment	<i>6. UP</i>			
8. Bonding material (if brick: record height of 4 courses & 4 bed joints in m)	<i>7. n/a</i>			
9. Dimensions of masonry as found	<i>8. <math>\approx 4</math></i>			
10. Other comments	<i>9. 0.58 m x 0.36 m x 0.14 m depth - 11.00 m OD</i>			Max Level: <del>10.20</del> m OD
				Min Level: 10.91 m OD

Stratigraphic Relationships:

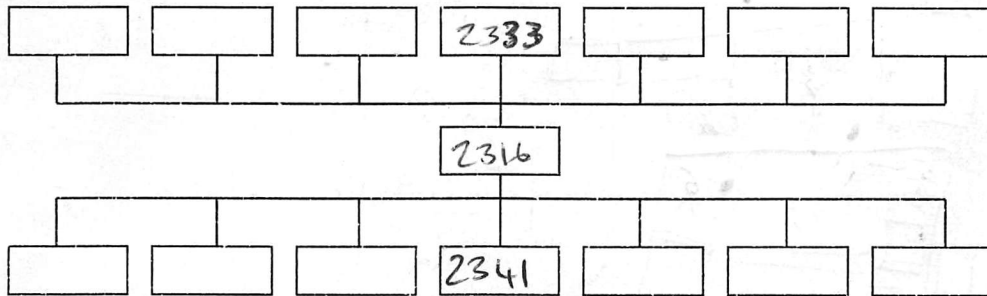

Physical Relationships:

Abuts:	Abutted by:
Cut by: <i>[2271] ?</i>	

Interpretation:	<input checked="" type="radio"/> internal	<input type="radio"/> external
<i>Brick Drain <del>masonry</del> <sup>alongside</sup> masonry [2036] (N-face) and running E-W. It is made of 2 courses of bricks and a pavement surface at the base it is cover by [2333].</i>		
Context same as:		

Sample No(s):	Drawing No(s): <i>2316 (x1)</i>
Photo No(s):	Sketch/levels overleaf: <input checked="" type="checkbox"/> Transferred to plan: <input checked="" type="checkbox"/>

Compiled by: <i>AC</i>	Date: <i>23-01-2015</i>	Checked by: <i>ac/9/15</i>	Tick when entered in database: <input type="checkbox"/>
---------------------------	----------------------------	-------------------------------	---

Context Number:  
2316

Level No.s  
TBM 11.68  
B/S 0.70  
IH 12.38

Level No.s  
TBM  
B/S  
IH

Level No.s  
TBM  
B/S  
IH

Level No.s  
TBM  
B/S  
IH

No.	F/S	R/L (m OD)	No.	F/S	R/L (m OD)	No.	F/S	R/L (m OD)	No.	F/S	R/L (m OD)
1	1.41	10.97	6	1.42	10.96	11	1.60	10.78			
2	1.39	10.99	7	1.56	10.82						
3	1.37	10.99	8	1.50	10.88						
4	1.38	11.00	9	1.52	10.86						
5	1.40	10.98	10	1.47	10.91						

