


Site Code: MNO12	Location: Area B	Grid Sq: 120/205	Context Type: CUT	Context Number: 2187
Deposit	1. L shape going from from [2131] to wall 2036.			Cut
1. Compaction	2. sharp corner			1. Shape in Plan
2. Colour	3.			2. Corners
3. Composition	4. sharp			3. Dimensions
4. Inclusions	5. vertical sides			4. Break of slope - Top
5. Interface	6. sharp			5. Sides
6. Dimensions	Text			6. Break of slope - Base
7. Other Comments	7. uneven			7. Base
8. Method/Conditions	8. EW and NS			8. Orientation
	9.			9. Inclination
	10. truncates 2194, [2205], 2206, 2050			10. Truncation
				11. Other comments
				Max Level: 11.96 m OD
				Min Level: 10.07 m OD

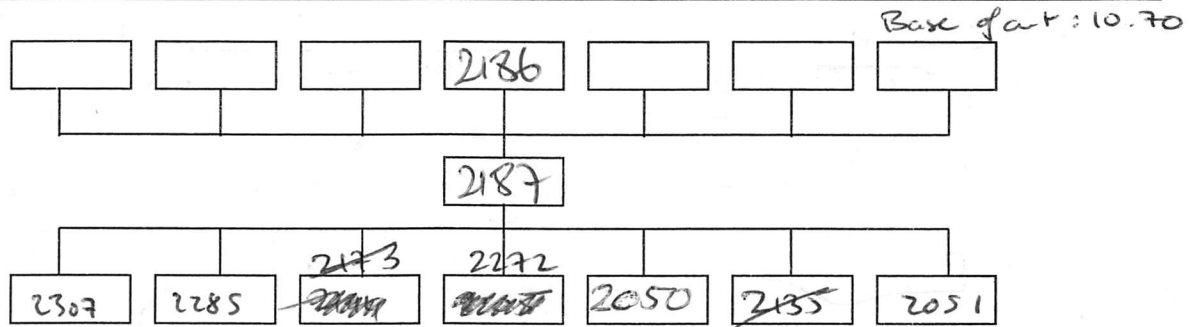

Interpretation:	Internal	External	Structural
Construction cut for the drain pipe [2186]			
Context same as:			

Finds: None <input type="checkbox"/> Pot <input type="checkbox"/> Bone <input type="checkbox"/> Glass <input type="checkbox"/> Metal <input type="checkbox"/> CBM <input type="checkbox"/> Flint <input type="checkbox"/> Wood <input type="checkbox"/> Leather <input type="checkbox"/>	
Other (specify):	
Sample No(s):	Drawing No(s): 2187 (x 1)
Photo No(s): -	Sketch/levels overleaf: <input checked="" type="checkbox"/> Transferred to plan: <input checked="" type="checkbox"/>

Compiled by: AC	Date: 20-01-2015	Checked by: en 4/9/15	Tick when entered in database: <input type="checkbox"/>
---------------------------	----------------------------	---------------------------------	---

Context Number:

287


Level No.s
TBM 11.68
B/S 0.73
IH 12.41

Level No.s
TBM ~~11.88~~
B/S ~~0.76~~
IH ~~12.44~~

Level No.s
TBM 11.68
B/S 0.76
IH 12.44

Level No.s
TBM 11.68
B/S 0.70
IH 12.38

No.	F/S	R/L (m OD)	No.	F/S	R/L (m OD)	No.	F/S	R/L (m OD)	No.	F/S	R/L (m OD)
1	0.45	11.96	6	0.56	11.85	8	0.90	11.54	12	1.28	11.10
2	0.14	11.47	7	0.68	11.71	9	1.49	10.95	13	1.29	11.09
3	1.14	11.27				10	1.50	10.94	14	1.54	10.74
4	1.23	11.18				11	1.46	10.99	15	1.58	10.70
5	1.34	11.07									

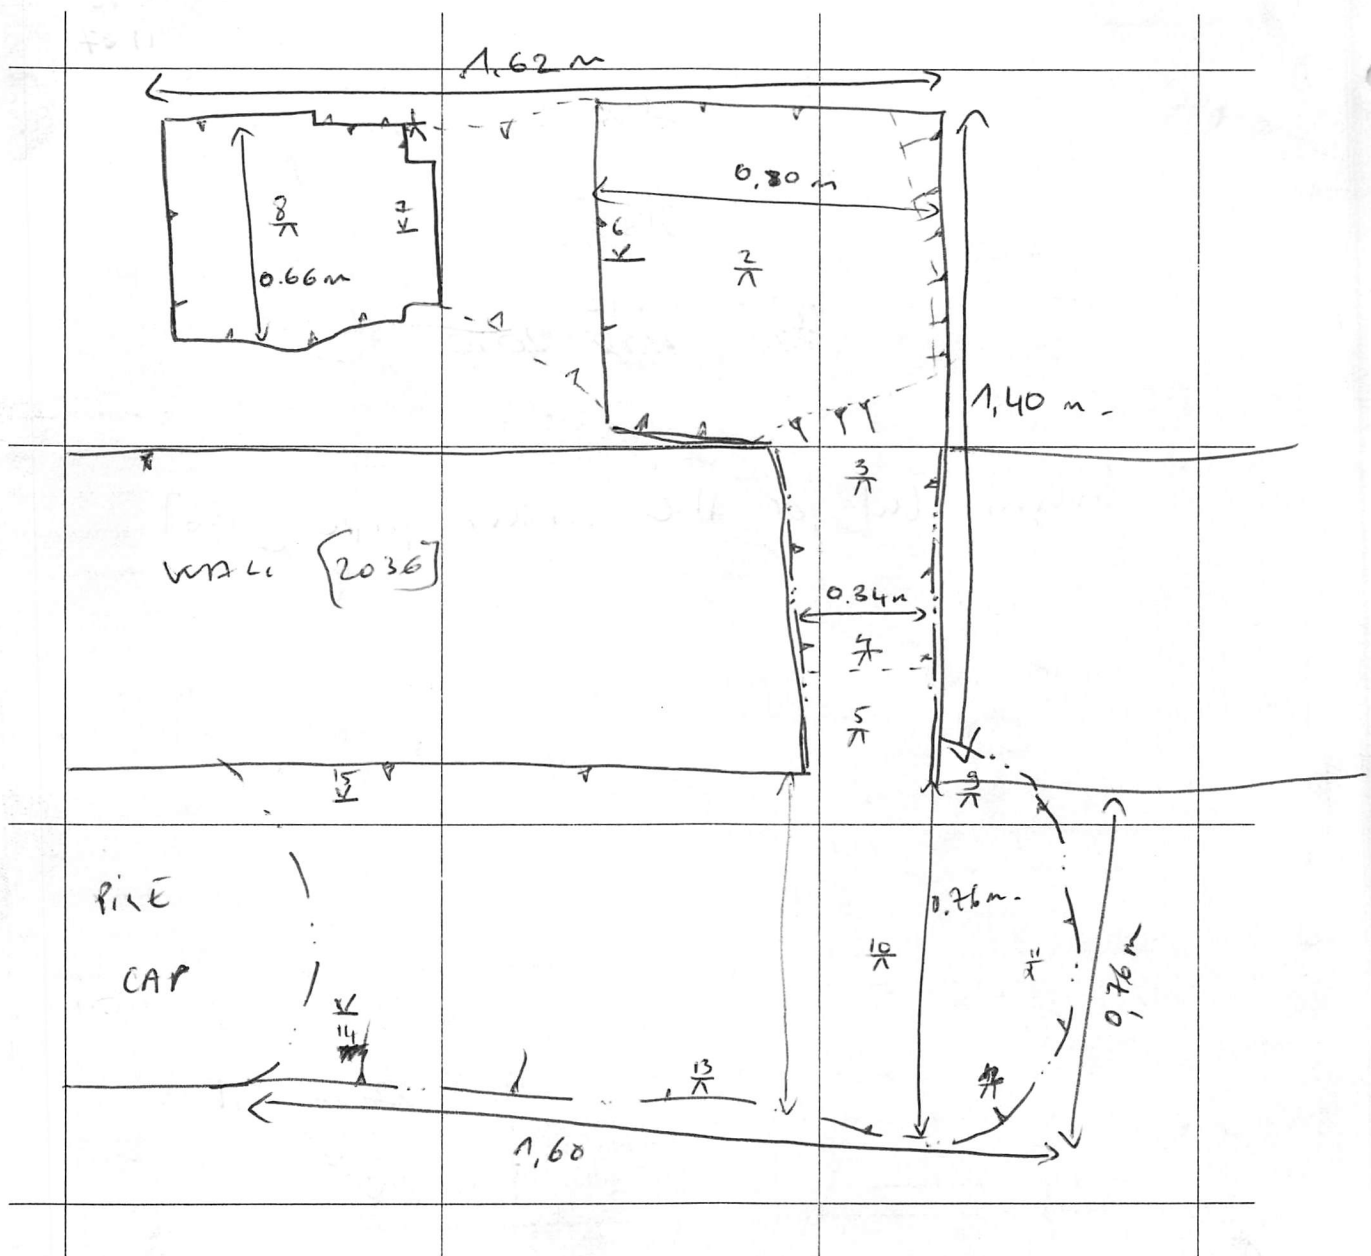

L-P: ARCHAEOLOGY

Sketch Plan & Notes