


Site Code: <b>MNO12</b>	Location: <b>Area B</b>	Grid Sq: <b>115/205 - 110/205</b>	Context Type: <b>CUT</b>	Context Number: <b>[2029]</b>
Deposit	<input checked="" type="checkbox"/> SUB-RECTANGULAR <input checked="" type="checkbox"/> SLIGHTLY ROUNDED, SQUARE IN <del>CORNERS</del> WEST <input checked="" type="checkbox"/> L 3.77m <del>W 1.03m</del> W, 1.13m, D.O. 38m. <input checked="" type="checkbox"/> SHARP <input checked="" type="checkbox"/> STEEP <input checked="" type="checkbox"/> SHARP <input checked="" type="checkbox"/> SLIGHTLY CONCAVE. <input checked="" type="checkbox"/> LINEAR RUNS W-E. <input checked="" type="checkbox"/> N/A. <input checked="" type="checkbox"/> TRUNCATED IN CENTRE. <input checked="" type="checkbox"/> NONE.			Cut
1. Compaction				1. Shape in Plan
2. Colour				2. Corners
3. Composition				3. Dimensions
4. Inclusions				4. Break of slope - Top
5. Interface				5. Sides
6. Dimensions				6. Break of slope - Base
7. Other Comments				7. Base
8. Method/Conditions	Text			8. Orientation
				9. Inclination
				10. Truncation
				11. Other comments
				Max Level: 10.83m OD
				Min Level: 10.14 m OD

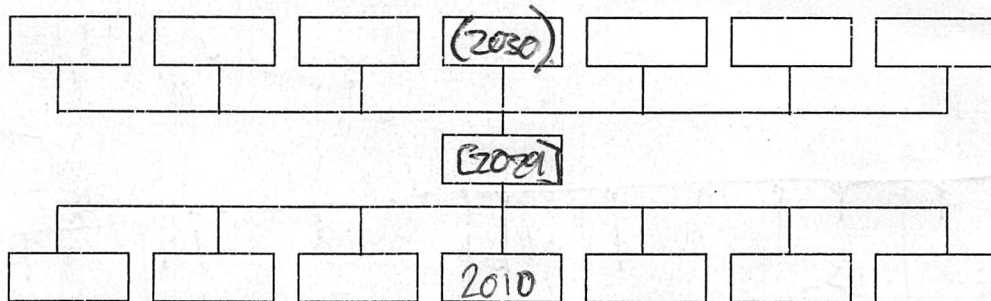

Interpretation:	Internal	External	Structural
<p>CONSTRUCTION CUT FOR BRICK DRAIN/CULVERT, WITH SLIGHTLY CONCAVE BASE TO AID SHAPING FOR DRAIN/CULVERT BASE. CORNERS ARE SLIGHTLY ROUNDED FOR THE FIRST 1.03m AT THE EAST END WHERE THERE IS THE TRUNCATION WITH [2010]. IT IS NOTED FROM THE MASONRY SHEET [2028] THAT THE CULVERT CHANGES SHAPE HERE TO A MORE CIRCULAR DRAIN. THE REST OF THE CUT HAS SQUARE SHARP SIDES.</p>			
Context same as:			

Finds: None <input checked="" type="checkbox"/> Pot <input type="checkbox"/> Bone <input type="checkbox"/> Glass <input type="checkbox"/> Metal <input type="checkbox"/> CBM <input type="checkbox"/> Flint <input type="checkbox"/> Wood <input type="checkbox"/> Leather <input type="checkbox"/>	
Other (specify):	
Sample No(s):	Drawing No(s): 2029 (x 2)
Photo No(s): 2600-05, 2007-11 & 2018	Sketch/levels overleaf: <input checked="" type="checkbox"/> Transferred to plan: <input checked="" type="checkbox"/>

Compiled by: <b>AS</b>	Date: <b>21/04/15</b>	Checked by: <b>c-23/m.s.</b>	Tick when entered in database: <input type="checkbox"/>
---------------------------	--------------------------	---------------------------------	---

Context Number:  
[2029]

Level No.s  
TBM 11.68  
B/S 0.76  
IH 12.44

Level No.s  
TBM  
B/S  
IH

Level No.s  
TBM  
B/S  
IH

Level No.s  
TBM  
B/S  
IH

No.	F/S	R/L (m OD)	No.	F/S	R/L (m OD)	No.	F/S	R/L (m OD)	No.	F/S	R/L (m OD)
1	1.70	10.74	6	1.93	10.51	11	2.27	10.17	16	1.64	10.80
2	1.90	10.54	7	2.09	10.35	12	2.30	10.14	17	1.76	10.68
3	1.87	10.57	8	1.93	10.51	13	2.28	10.16			
4	1.68	10.76	9	2.08	10.36	14	1.61	10.83			
5	1.97	10.47	10	2.07	10.37	15	1.75	10.69			

