


Site Code: <b>MNO12</b>	Location: <b>3</b>	Grid Sq: <b>115/210</b>	Context Type: <b>DEP</b>	Context Number: <b>2348</b>
Deposit	① LOOSE (COBBLES) FIRM (MATRIX)			Cut
1. Compaction	② DARK GREYISH BROWN			1. Shape in Plan
2. Colour	③ COBBLES (100-200mm) ROUNDED			2. Corners
3. Composition	WITH A SANDY SILT MATRIX			3. Dimensions
4. Inclusions	④ OCCASIONAL CRM FRACS			4. Break of slope - Top
5. Interface	(SMALL) CHARCOAL			5. Sides
6. Dimensions	MODERATE MORTAR FRACS			6. Break of slope - Base
7. Other Comments	MODERATE ROOF TILE			7. Base
8. Method/Conditions	Text FRACS 100mm - 200mm			8. Orientation
A LOOSE COBBLE DUMP WITH OTHER DEMO DEBRIS IN IT				9. Inclination
				10. Truncation
				11. Other comments
				Max Level: <del>11.29</del> m OD 10.75
				Min Level: <del>10.80</del> m OD 10.50

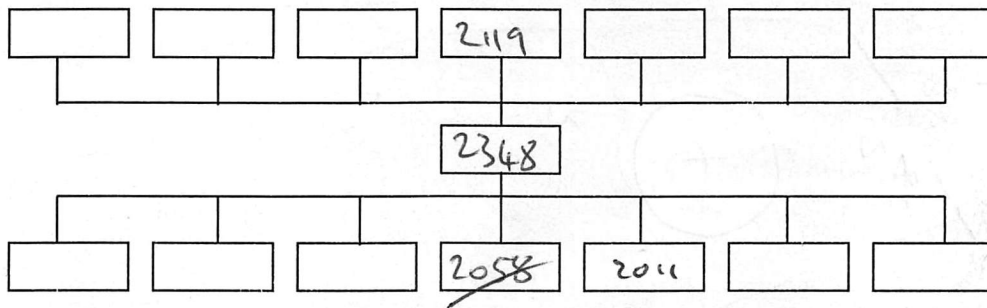

Interpretation:	Internal	External	Structural
A DEPOSIT OF DEP SITE COBBLES WITH ROOF TILES AND MORTAR DIRECTLY BELOW THE CONSTRUCTION LEVEL OF CRM BUILDINGS - NEXT TO POSSIBLY REUSED COBBLE CONCRETE FOUNDATION. THESE ARE PROBABLY DISPLACED COBBLES FROM A CRM YARD, SOME REUSED AS [2347]. CRM SAMPLE TAKEN			
Context same as:			

Finds: None <input type="checkbox"/> Pot <input type="checkbox"/> Bone <input type="checkbox"/> Glass <input type="checkbox"/> Metal <input type="checkbox"/> CBM <input checked="" type="checkbox"/> Flint <input type="checkbox"/> Wood <input type="checkbox"/> Leather <input type="checkbox"/>	
Other (specify):	
Sample No(s): <del>2348</del>	Drawing No(s): _____ (x )
Photo No(s):	Sketch/levels overleaf: <input type="checkbox"/> Transferred to plan: <input type="checkbox"/>

Compiled by: <b>BSS</b>	Date: <b>26/1/15</b>	Checked by: <b>a. et al.</b>	Tick when entered in database: <input type="checkbox"/>
----------------------------	-------------------------	---------------------------------	---

Context Number:

2348

Level No.s

TBM 11.82  
B/S 0.66  
IH 12.46

Level No.s

TBM 11.50  
B/S 0.66  
IH 12.16


Level No.s

TBM  
B/S  
IH

Level No.s

TBM  
B/S  
IH

No.	F/S	R/L (m OD)	No.	F/S	R/L (m OD)	No.	F/S	R/L (m OD)	No.	F/S	R/L (m OD)
1	1.41	11.05	6	1.57	10.87	7	10.75	10.59			
2	1.37	11.09	7	1.62	10.86	8	10.79	10.56			
3	1.40	11.06	8	1.66	10.80		10.76	10.50			
4	1.40	11.06					10.76				
5	1.61	10.85					10.55				

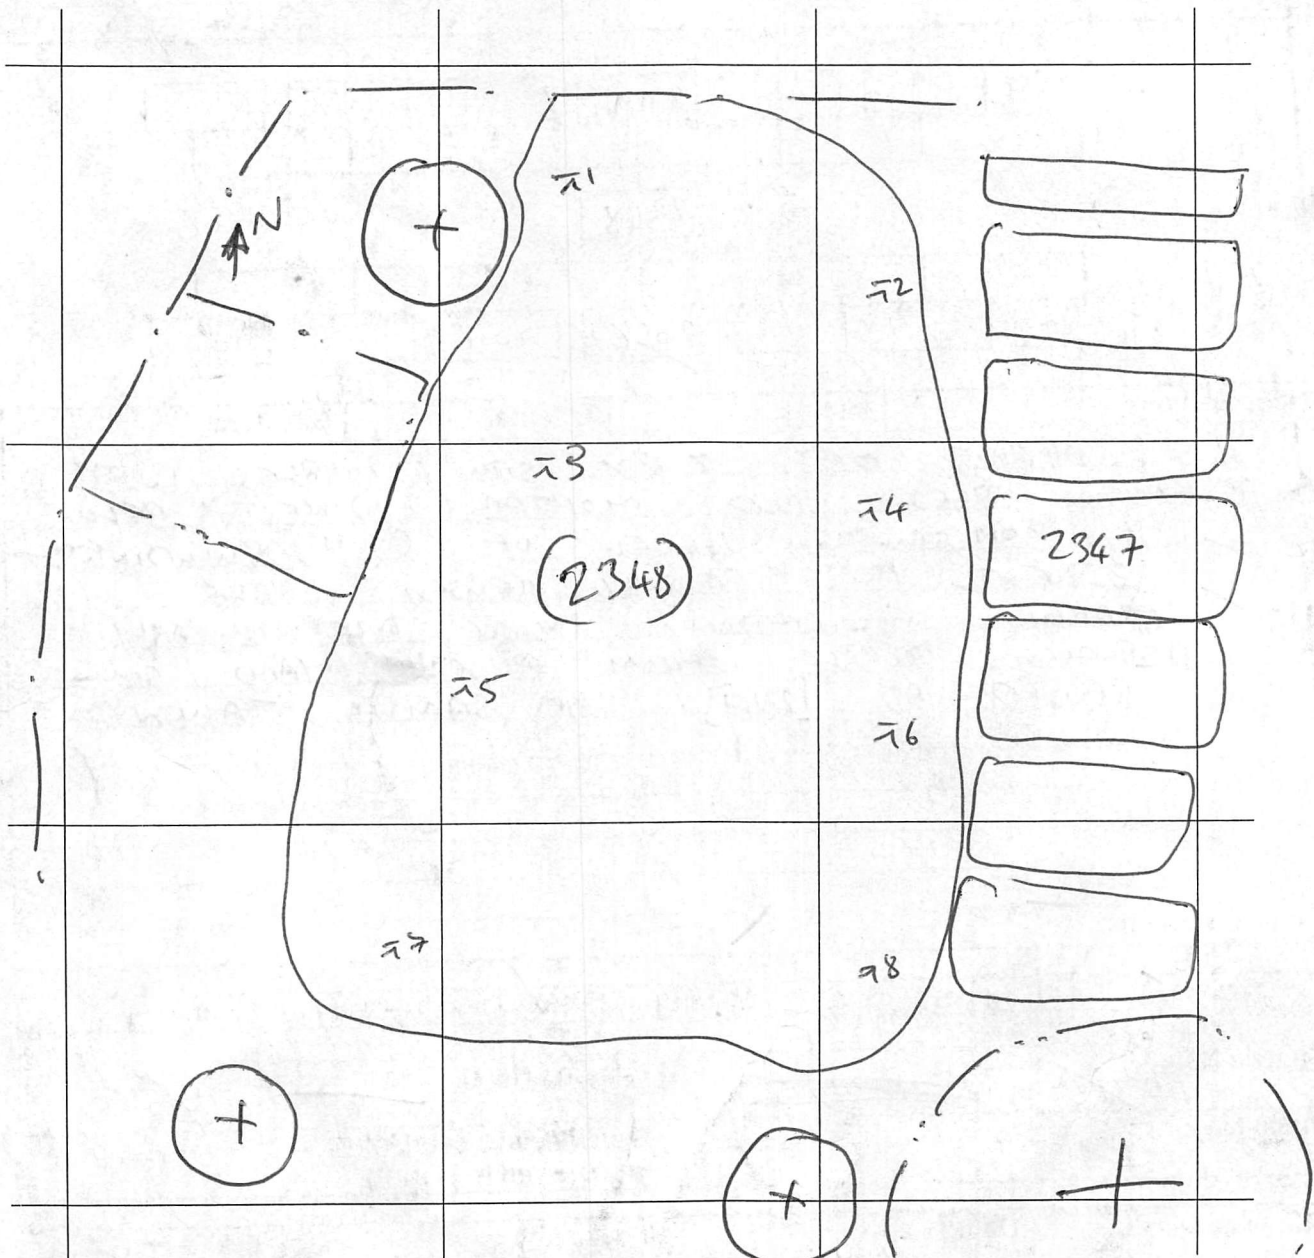

L-P: ARCHÆOLOGY