Site Code: MNO12	Location: AREA C	Grid Sq: 135 | 200	Context Type: cut	Context Number: [3022]
Deposit				Cut
1. Compaction	1. ~~Sub-rectangular~~ linear			1. Shape in Plan
2. Colour	2. N/A			2.Corners
3. Composition	3. 0.80m (E-W); 1.68m x 0.10m			3. Dimensions
4. Inclusions	4. sharp			4. Break of slope – Top
5. Interface	5. vertical			5. Sides
6. Dimensions	6. sharp			6. Break of slope – Base
7. Other Comments	7. flat + 2 rounded depressions			7. Base
8. Method/Conditions	Text 8. N-S			8. Orientation
	9. /			9. Inclination
	10. [+]			10. Truncation
	11. /			11. Other comments
				Max Level: 10.43 m OD
				Min Level: 10.23 m OD

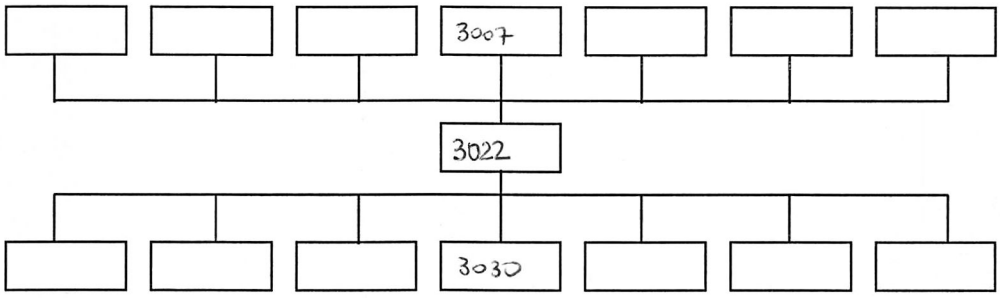

Interpretation:	Internal	External	Structural

Cut for wall [3007]. Two rounded depressions at the bottom of the ~~west~~ brick wall, right where two ~~w~~ remains of wooden planks running (E-W) were observed during the demolition of the wall.

INDENTATIONS IN BASE INDICATE PILES TO HOLD PLANKS TO SUPPORT WALL STRUCTURE ON SOFT GROUND.

Context same as:

Finds: None ☑ Pot ☐ Bone ☐ Glass ☐ Metal ☐ CBM ☐ Flint ☐ Wood ☐ Leather ☐	
Other (specify):	
Sample No(s): /	Drawing No(s): 3022 (x1)
Photo No(s): /	Sketch/levels overleaf: ☐ Transferred to plan: ☑

Compiled by:	Date:	Checked by:	Tick when entered in database:
MK, NJ	17/04/2015	8/10/15	☐

Context Number: [3022]

Level No.s 1-13	Level No.s	Level No.s	Level No.s
TBM 11.40	TBM	TBM	TBM
B/S 0.53	B/S	B/S	B/S
IH 11.93	IH	IH	IH

No.	F/S	R/L (m OD)	No.	F/S	R/L (m OD)	No.	F/S	R/L (m OD)	No.	F/S	R/L (m OD)
1	1.58	10.35	6	1.70	10.23	11	1.58	10.35			
2	1.60	10.33	7	1.57	10.36	12	1.50	10.43			
3	1.67	10.26	8	1.59	10.34	13	1.53	10.40			
4	1.58	10.35	9	1.55	10.37						
5	1.58	10.35	10	1.57	10.36						

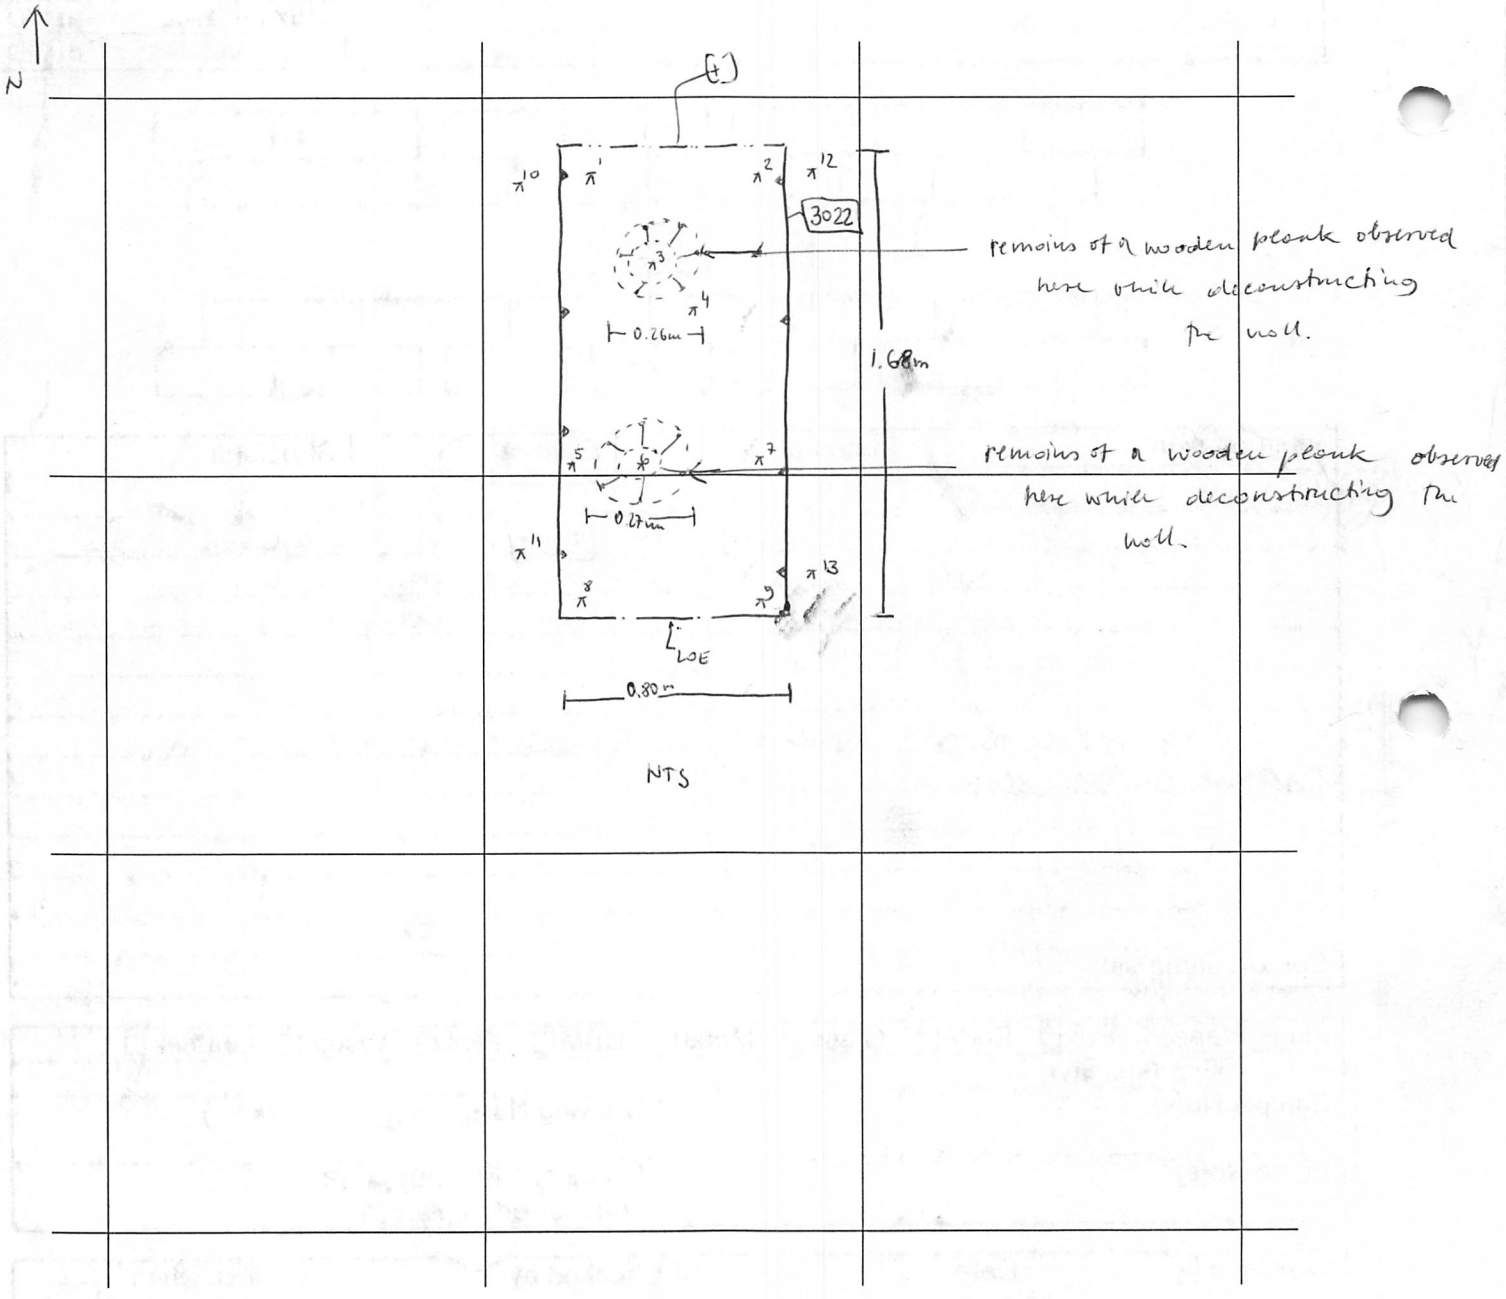

Sketch Plan & Notes

L-P:ARCHÆOLOGY