Site Code: MNO12	Location: D	Grid Sq: 145/230	Context Type: DEPOSIT	Context Number: 4119

Deposit	Text	Cut
1. Compaction	(1) FRIABLE/FIRM	1. Shape in Plan
2. Colour	(2) MARK ~~BROWN~~ BLACK/BROWN, FLECKS OF WHITE	2. Corners
3. Composition	(3) CLAY SILT	3. Dimensions
4. Inclusions	(4) CBM (FREQ), POT (OCC), CLAY PIPE (OC) WORKED BONE (OCC), SMALL PEBBLES 5-10mm (OCC)	4. Break of slope – Top
5. Interface	(5) WELL DEFINED	5. Sides
6. Dimensions	(6) 0.89m N-S, 0.73m E-W, m 0.14m THICK	6. Break of slope – Base
7. Other Comments		7. Base
8. Method/Conditions		8. Orientation
		9. Inclination
		10. Truncation
		11. Other comments

Max Level: 10.80 m OD
Min Level: 10.65 m OD

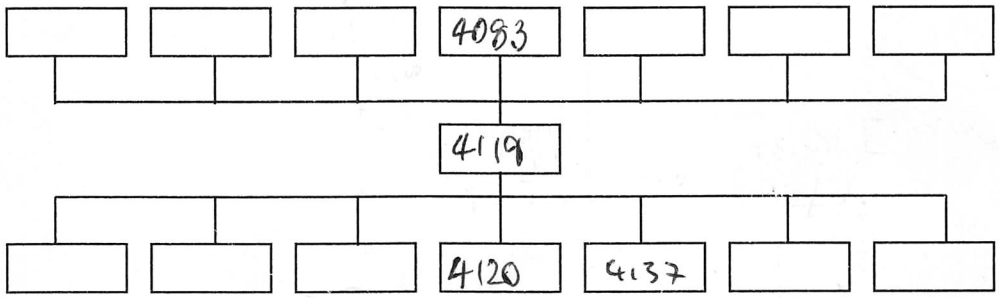

Interpretation:	Internal	External	Structural

STRUCTURAL BACKFILL OF ~~WALL~~ T-SHAPED WALL CUT. PARTS OF BRICK WALL STILL SURVIVING BUT TRUNCATED BY DRAIN AND ~~BUILDING~~ LATER BUILDING. THE REMAINING WALL CUTS APPEAR TO HAVE BEEN BACKFILLED, POSSIBLY TO CREATE A LEVEL SURFACE FOR BUILDING ON OR PERHAPS

Context same as:

Finds: None ☐ Pot ☑ Bone ☑ Glass ☐ Metal ☐ CBM ☐ Flint ☐ Wood ☐ Leather ☐
Other (specify): CLAY PIPE, WORKED BONE

Sample No(s): —	Drawing No(s): 4119 (x 1)
Photo No(s): —	Sketch/levels overleaf: ☑ Transferred to plan: ☑

Compiled by:	Date:	Checked by:	Tick when entered in database:
AB	30/6/15	— 9/10/15	☐

L-P:ARCHÆOLOGY

Context Number: 4121

Level No.s	Level No.s	Level No.s	Level No.s
TBM 11.40	TBM	TBM	TBM
B/S 0.79	B/S	B/S	B/S
IH 12.19	IH	IH	IH

4121
4122

No.	F/S	R/L (m OD)	No.	F/S	R/L (m OD)	No.	F/S	R/L (m OD)	No.	F/S	R/L (m OD)
1	1.39	10.80									
2	1.42	10.77									
3	1.48	10.71									
4	1.54	10.65									

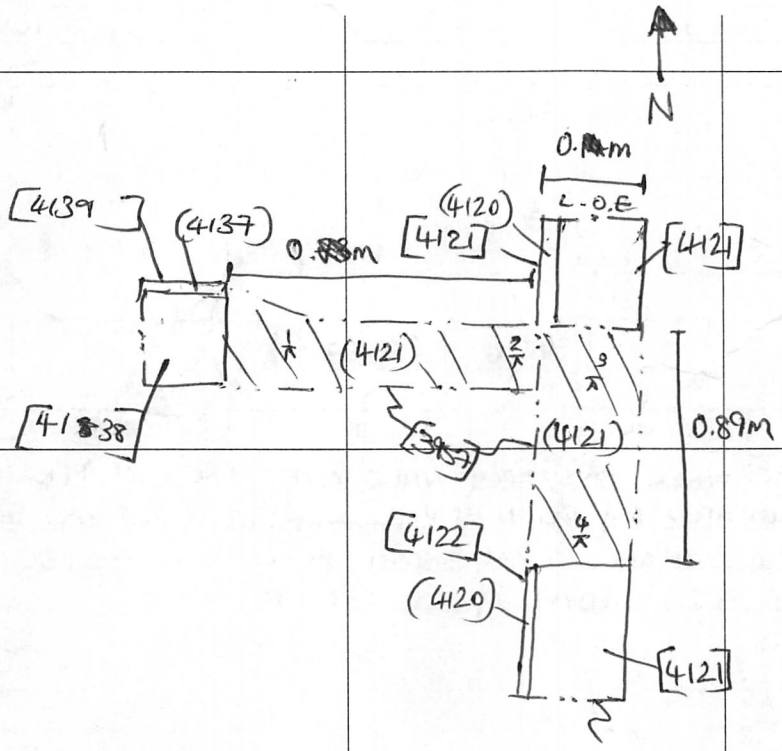

Sketch Plan & Notes

L-P:ARCHÆOLOGY