Site Code:	Location:	Grid Sq:	Context Type:	Context Number:
MNO12	G	145/235	CUT	[4753]

Deposit		Cut
1. Compaction	1. LINEAR (?)	1. Shape in Plan
2. Colour	2. ~~NOT~~ PERCEIVABLE	2. Corners
3. Composition	3. EW 2.46m × NS 1.2m × DEPTH 0.16m	3. Dimensions
4. Inclusions	4. GRADUAL	4. Break of slope – Top
5. Interface	5. GRADUAL	5. Sides
6. Dimensions	6. GRADUAL	6. Break of slope – Base
7. Other Comments	7. FLAT	7. Base
8. Method/Conditions	8. EW (?)	8. Orientation
	9. –	9. Inclination
10. CUT BY		10. Truncation
11. – 4555, 4404, 4403		11. Other comments

Max Level: 9.93 m OD

Min Level: 9.82 m OD

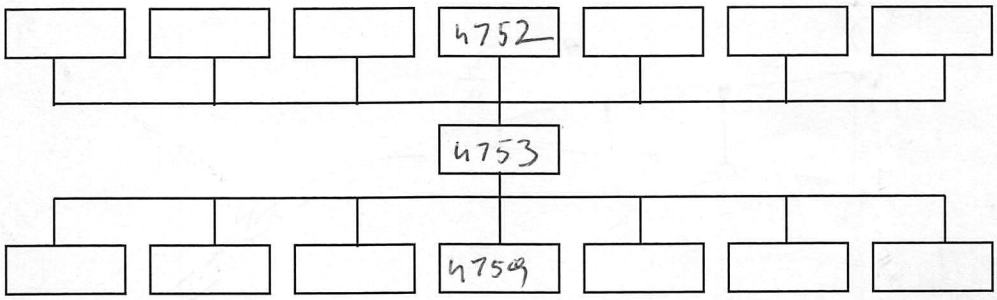

Interpretation:	Internal	External	Structural

HEAVILY TRUNCATED LINEAR FEATURE, OF UNCERTAIN PURPOSE. HORIZONTALLY IT IS TRUNCATED BY ~~THE~~ BASEMENT WALL [4621]; THE CUT IS CURVING SE;

Context same as:

Finds: None ☐ Pot ☐ Bone ☐ Glass ☐ Metal ☐ CBM ☐ Flint ☐ Wood ☐ Leather ☐

Other (specify):

Sample No(s): —	Drawing No(s): 4753 (x 1)
Photo No(s): —	Sketch/levels overleaf: ☑ Transferred to plan: ☑

Compiled by:	Date:	Checked by:	Tick when entered in database:
TM	18/11/16	← 26/1/17.	☐

Context Number: 4753

Level No.s 8-7	Level No.s	Level No.s	Level No.s
TBM 12.00	TBM	TBM	TBM
B/S -0.2	B/S	B/S	B/S
IH 11.8	IH	IH	IH

No.	F/S	R/L (m OD)	No.	F/S	R/L (m OD)	No.	F/S	R/L (m OD)	No.	F/S	R/L (m OD)
1	1.97	9.83	6	1.79	10.01						
2	2.80	9.37	7	2.22	9.58						
3	2.13	9.67									
4	1.88	9.92									
5	2.02	9.78									

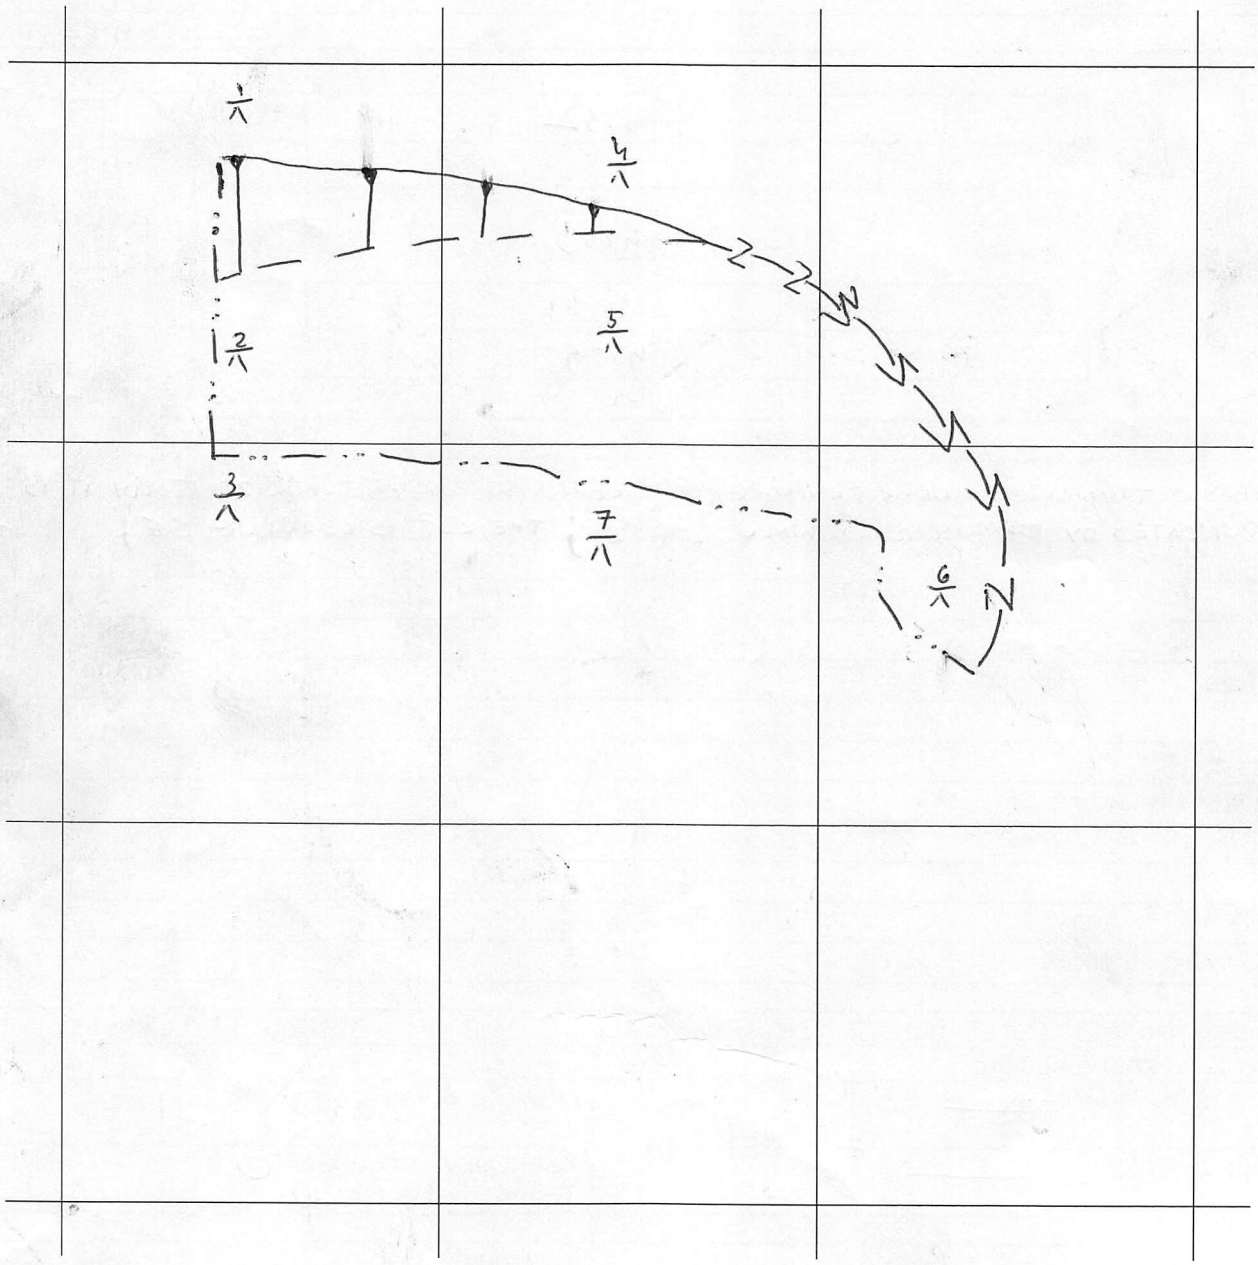

1
2
B5

Sketch Plan & Notes

L-P:ARCHÆOLOGY