Site Code: MNO12	Location: Area A	Grid Sq: 8 of 2	Context Type: FILL	Context Number: 1478

Deposit	Text	Cut
1. Compaction	1. Compact.	1. Shape in Plan
2. Colour	2 - mid grey (?)	2. Corners
3. Composition	3. Sandy silt.	3. Dimensions
4. Inclusions	4. ~~Inclusions of~~ Frequent inclusions of gravel (up to 6-20 cm)	4. Break of slope – Top
5. Interface	5 - well defined	5. Sides
6. Dimensions	6. 4.78 m (E-W) x 0.56 to 0.76 m thick -	6. Break of slope – Base
7. Other Comments	7 - western edge of this pit not in section 43.	7. Base
8. Method/Conditions	8. dry, machine dug.	8. Orientation
		9. Inclination
		10. Truncation
		11. Other comments
		Max Level: 8.56 m OD
		Min Level: ~~8.06~~ 8.50 m OD

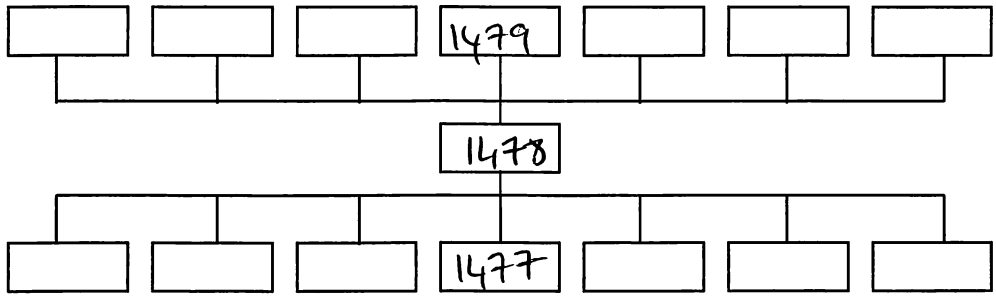

Interpretation:	Internal	External	Structural
lower fill of [1477].			
Context same as:			

Finds: None ☑ Pot ☐ Bone ☐ Glass ☐ Metal ☐ CBM ☐ Flint ☐ Wood ☐ Leather ☐	
Other (specify):	
Sample No(s):	Drawing No(s): S.43. (x1)
Photo No(s):	Sketch/levels overleaf: ☑ Transferred to plan: ☐

Compiled by:	Date:	Checked by:	Tick when entered in database:
AC	3-02-2015	a 4/2/15	☐

Context Number: 1478

Level No.s	Level No.s	Level No.s	Level No.s
TBM	TBM	TBM	TBM
B/S / total	B/S	B/S	B/S
IH / Station	IH	IH	IH

No.	F/S	R/L (m OD)	No.	F/S	R/L (m OD)	No.	F/S	R/L (m OD)	No.	F/S	R/L (m OD)
43.1		8.18									
43.2		8.20									

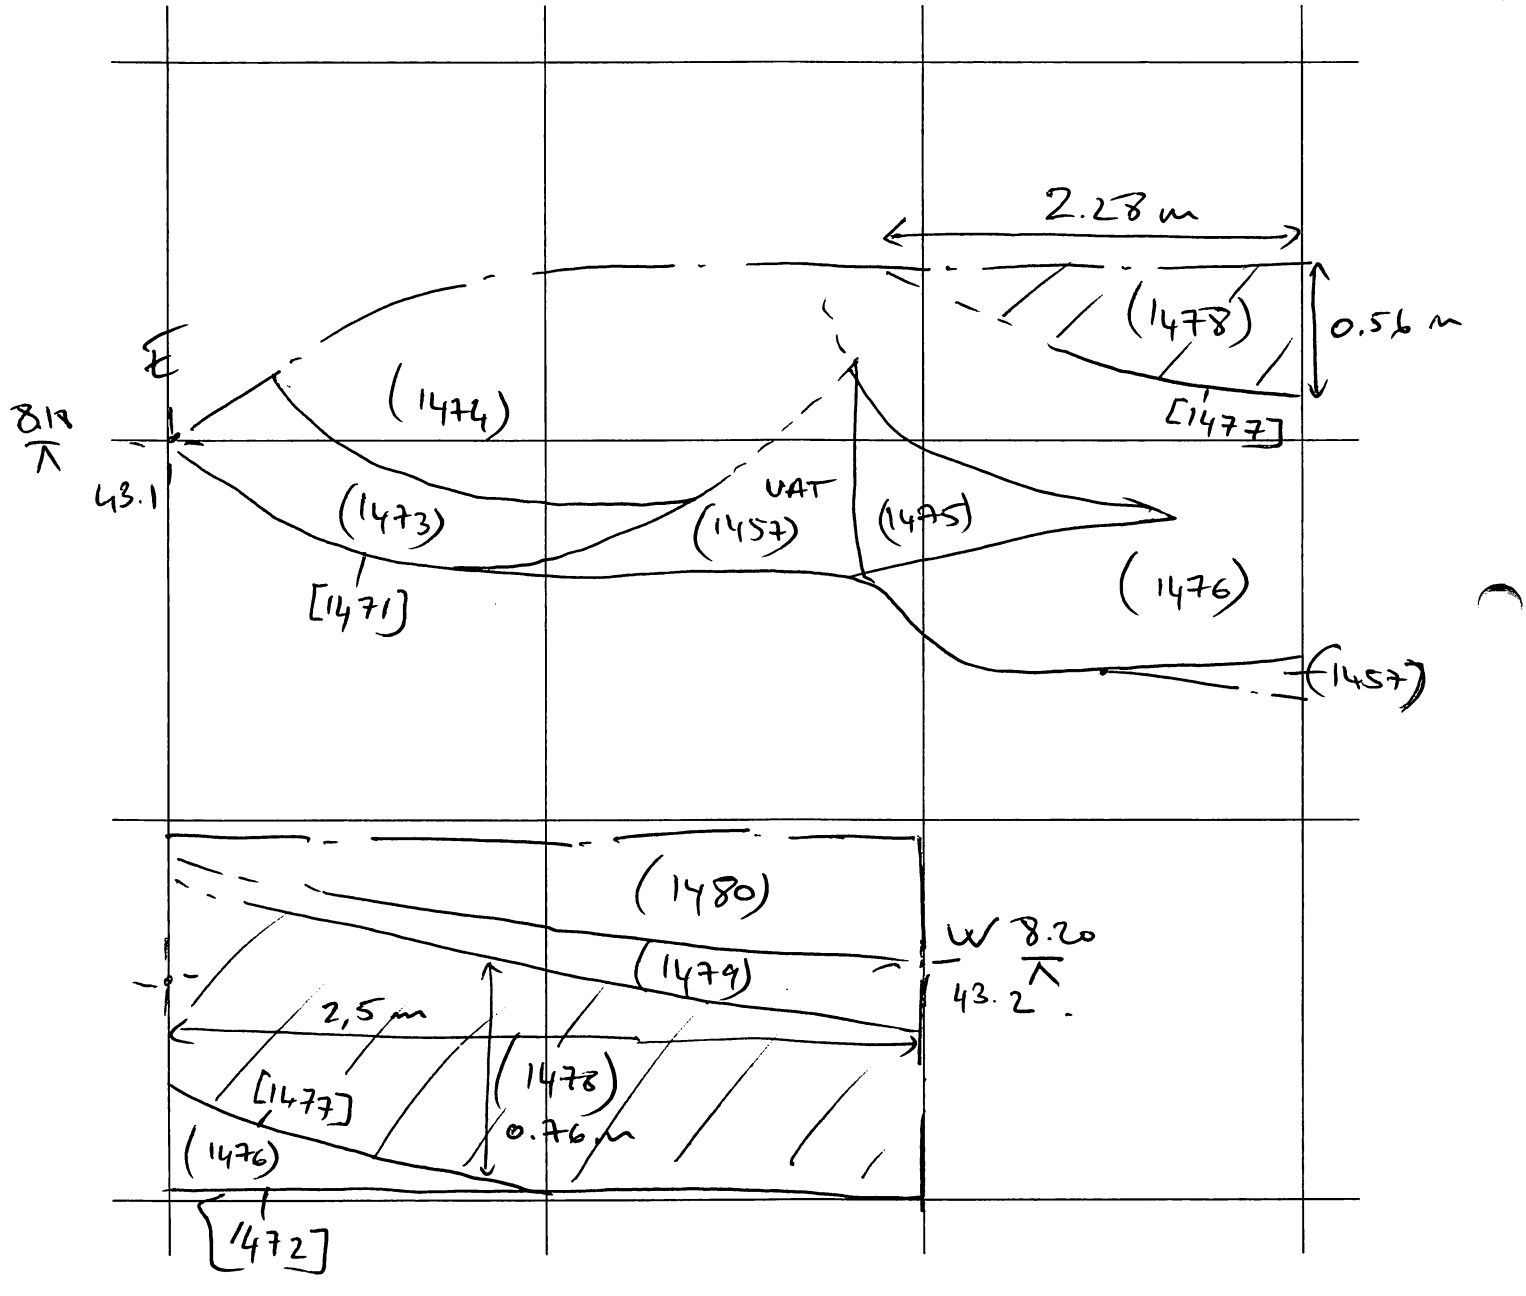

Sketch Plan & Notes

L-P:ARCHÆOLOGY