Site Code: MNO12	Location: B	Grid Sq: 120/205 120/210	Context Type: FILL	Context Number: 2525

Deposit		Cut
1. Compaction	1. ~~for~~ loose	1. Shape in Plan
2. Colour	2. light greyish beige	2. Corners
3. Composition	3. sand	3. Dimensions
4. Inclusions	4. freq. CBM frag., occa Pot,	4. Break of slope – Top
5. Interface		5. Sides
6. Dimensions	5. clear	6. Break of slope – Base
7. Other Comments	6. 0.80m (E-W), 0.78m (N-S); H:	7. Base
8. Method/Conditions	Text	8. Orientation
	7. -	9. Inclination
	8. mattock, trowel / dry-cold	10. Truncation
		11. Other comments

(R) 10.28

Max Level: 10.28m m OD

Min Level: 10.58m m OD

10.28

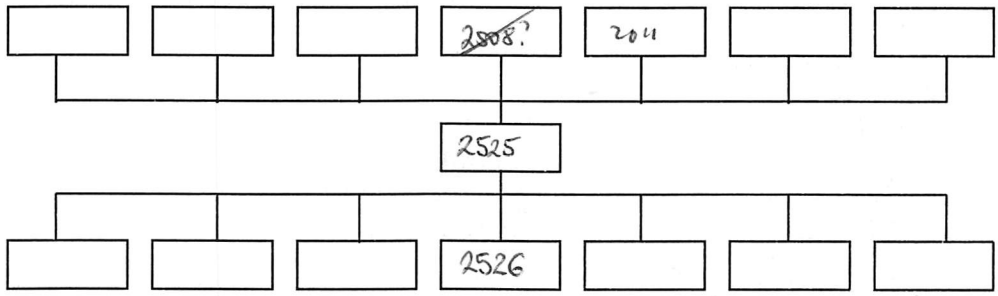

Interpretation:	Internal	External	Structural

loose sandy fill of pit 2526.
Possible levelling? Unclear function of the pit.

Context same as:

Finds: None ☐ Pot ☑ Bone ☐ Glass ☐ Metal ☐ CBM ☐ Flint ☐ Wood ☐ Leather ☐
Other (specify):

Sample No(s): 11	Drawing No(s): ~~2~~ (~~2~~)
Photo No(s): 11	Sketch/levels overleaf: ☑ Transferred to plan: ☑

Compiled by: MK	Date: 10/02/2015	Checked by:	Tick when entered in database: ☐

L-P:ARCHÆOLOGY

Context Number: 2525

Level No.s	1		Level No.s	Level No.s	Level No.s
TBM	11.88	11.50	TBM	TBM	TBM
B/S	0.24	0.24	B/S	B/S	B/S
IH	12.04	11.74	IH	IH	IH

No.	F/S	R/L (m OD)	No.	F/S	R/L (m OD)	No.	F/S	R/L (m OD)	No.	F/S	R/L (m OD)
1	1.46	10.58	R		10.28						

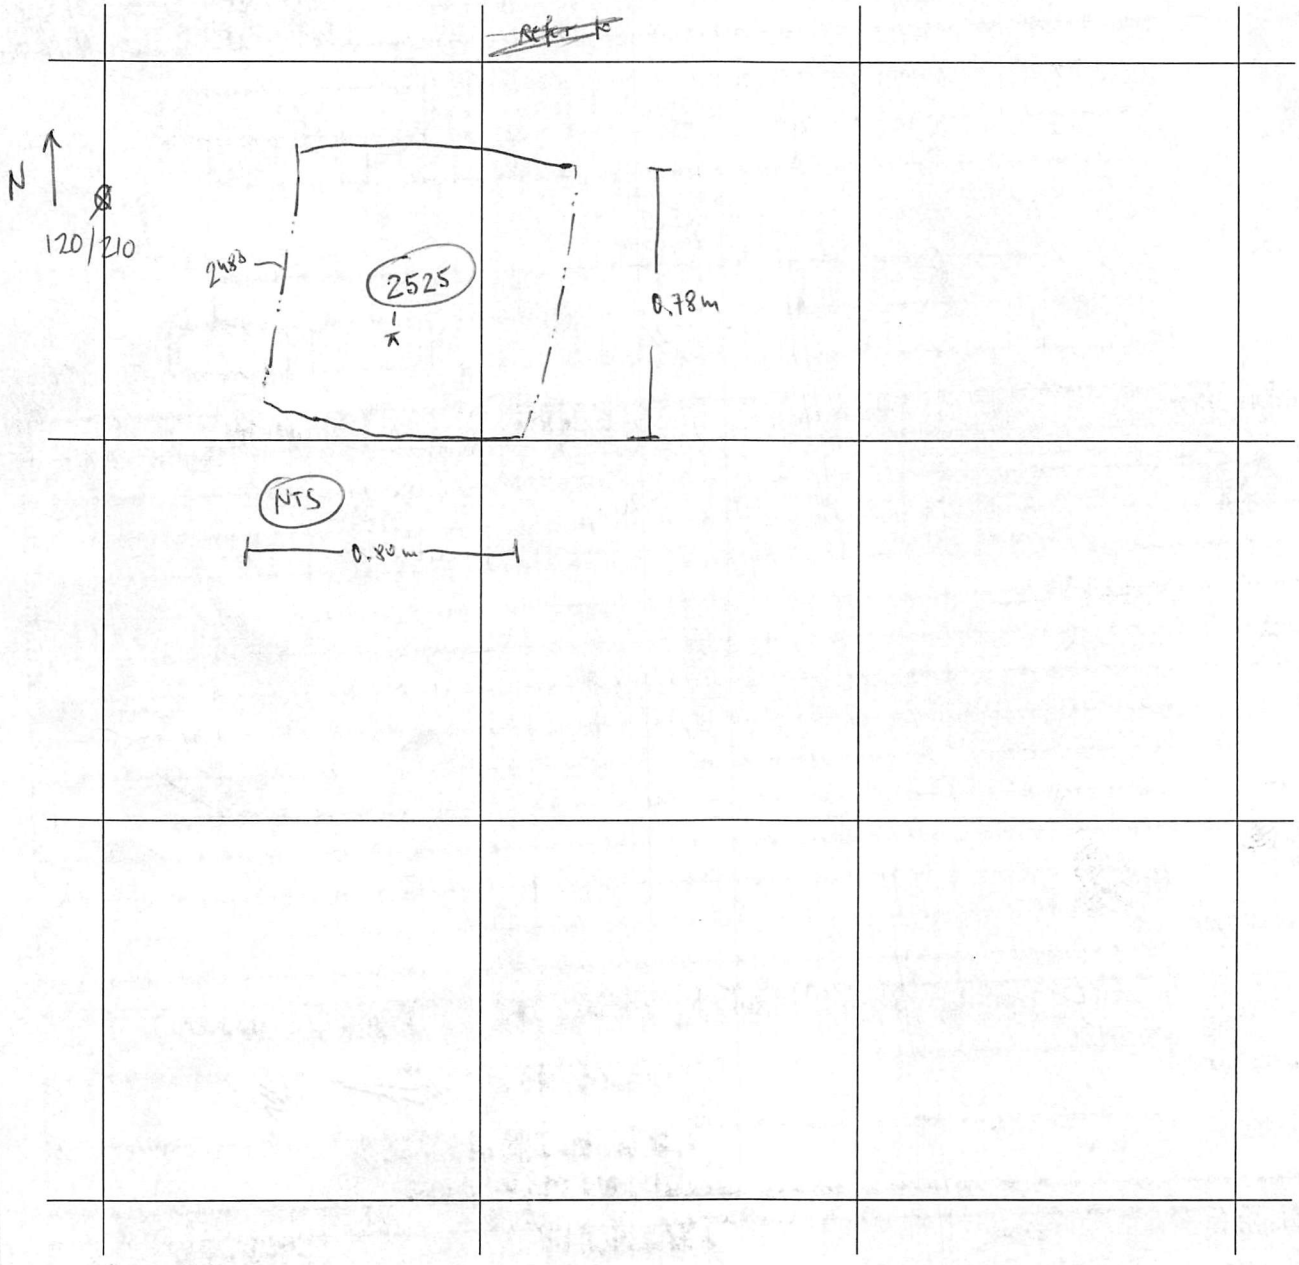

Sketch Plan & Notes

L-P:ARCHÆOLOGY